

Jan 31/72
for location

PEARL RIVER
W 122
12-18-72

MISSISSIPPI
BOARD OF WATER COMMISSIONERS
416 North State Street
Jackson, Mississippi 39201

CODED

WATER WELL DRILLERS LOG

12/18 date well completed 1972 W. Bud Denton & Son firm name Pearl River county well located

LANDOWNER: Murphy
Groves
Picayune Miss.
(mailing address)

description of formations encountered	from	to
	White shale	0
white sand	26	75
Blue shale	75	150
white sand	150	176
Blue shale	176	251
Blue sand	251	273

WELL LOCATION:
sec. 6 T E N 8 R 18 E
3 miles NW of Picayune
(distance) (direction) (nearest town)

WELL PURPOSE: none
(home, irrigation, municipal, industrial)

- WELL COMPLETION DATA:
- (1) diameter (inches) 2 11
 - (2) total depth (feet) 273
 - (3) static water level (feet) 8 below/above top of ground.
 - (4) casing galv. 268
(material) (depth)
2 11 if telescope see back.
(size)
 - (5) screen 2x5 268
(length) (depth to top)
2 11 (size) galv. (material)
 - (6) pump 1/2 450
(HP) (yield gpm)
elect. (type power)
 - (7) electric log (yes or no) _____
- (organization running log) _____
- (8) how well bottom plugged sand short

CODED


MAP 1075
WATER 1075

DRILLERS REMARKS:

WATER 1075

If well telescopes please sketch and show depths.

GROUND LEVEL

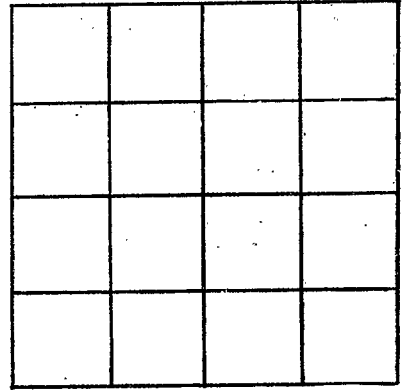

SECTION _____

Please indicate well location X.

ADDITIONAL INFORMATION

If more than one screen,
show locations of each on sketch.