

**PEARL RIVER**  
 W 123  
 5-3-73  
 E log # 107

MISSISSIPPI  
 BOARD OF WATER COMMISSIONERS  
 416 North State Street  
 Jackson, Mississippi 39201

**CODED**

WATER WELL DRILLERS LOG

*Sumpkin Well Sec. Pearl River*  
 date well completed 19 *5-3-73* firm name county well located

LANDOWNER: *Picayune Country Club*  
*Picayune Miss.*  
 (mailing address)

WELL LOCATION:  
 sec. 1 T 6 N R 17 E  
1 miles North of Picayune  
 (distance) (direction) (nearest town)

WELL PURPOSE: *Irrigation*  
 (home, irrigation, municipal, industrial)

- WELL COMPLETION DATA:
- (1) diameter (inches) 2"
  - (2) total depth (feet) 1134
  - (3) static water level (feet) 0 below above top of ground.
  - (4) casing 2" Gal. 1114'  
 (material) (depth)
  - if telescope see back.  
 (size)
  - (5) screen 20' 1114'  
 (length) (depth to top)
  - 2" Gal.  
 (size) (material)
  - (6) pump                    
 (HP) (yield gpm)
  - (type power)
  - (7) electric log Yes (USGS)  
 (yes or no)
  - (organization running log)
  - (8) how well bottom plugged Sand Shrub

description of formations encountered	from	to
Clay	0	15
Sand	15	110
Clay	110	150
Hard Sand	150	170
Clay	170	240
Sand	240	260
Clay	260	335
Sand	335	395
Clay	395	500
Sand	500	645
Clay	645	700
Hard Sand	700	1134


**CODED**

DRILLERS REMARKS:

MAY 24 1973

If well telescopes please sketch and show depths.

GROUND LEVEL

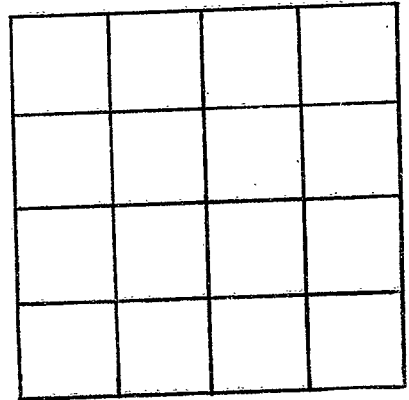

SECTION \_\_\_\_\_

Please indicate well location X.

ADDITIONAL INFORMATION

If more than one screen, show locations of each on sketch.