

Pearl River
W 124
3-30-73

MISSISSIPPI
 BOARD OF WATER COMMISSIONERS
 416 North State Street
 Jackson, Mississippi 39201

CODED

WATER WELL DRILLERS LOG

3-30 1973 Panthers well serv Pearl River
 date well completed firm name county well located

LANDOWNER: William Powe

description of formations encountered	from	to
Surface clay	0	10
Sand + Gravel	10	72
Blue clay	72	335
Sand	335	462
Blue clay	462	620
Sand	620	675
Blue clay	675	760
Sand	760	812
Blue clay	812	878
Fine sand	878	900
Blue clay	900	1100
Sand + Gravel	1100	1170
Blue clay	1170	1460
Sand	1460	1533

Picayune Miss
 (mailing address)

WELL LOCATION:

sec. 18 T. 6 S. R. 17 W.
1 miles West of Picayune
 (distance) (direction) (nearest town)

WELL PURPOSE: Home
 (home, irrigation, municipal, industrial)

WELL COMPLETION DATA:


- (1) diameter (inches) 2
- (2) total depth (feet) 1533
- (3) static water level (feet) Flow above top of ground.
- (4) casing Galv. 1513
 (material) (depth)
2 if telescope see back.
 (size)
- (5) screen 20' 1533
 (length) (depth to top)
.012 2 S. steel
 (size) (material)
- (6) pump ✓ ✓
 (HP) (yield gpm)
✓
 (type power)
- (7) electric log No
 (yes or no)
- (organization running log)
- (8) how well bottom plugged Bo. Valve

CODED

DRILLERS REMARKS: 33 lbs. Pressure

If well telescopes please sketch and show depths.

GROUND LEVEL

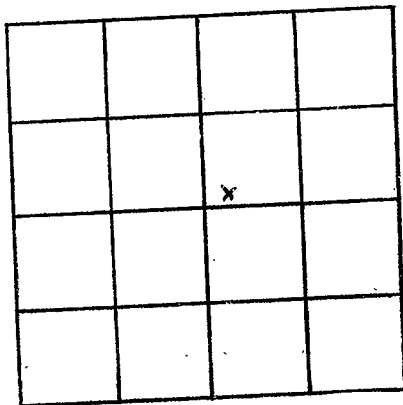

SECTION 18

Please indicate well location X.

ADDITIONAL INFORMATION

If more than one screen,
show locations of each on sketch.