

P.R.
W134
12-11-73

MISSISSIPPI
BOARD OF WATER COMMISSIONERS
416 North State Street
Jackson, Mississippi 39201

CODED

WATER WELL DRILLERS LOG

12-11-1973 date well completed
Bud Luten & Son firm name
Paul Kinn county well located

LANDOWNER:
Eddy Herring
Peachum, Miss.
(mailing address)


description of formations encountered	from	to
Red Shale	0	16
White Sand Rock	16	76
Blue Shale	76	370
Gray Sand	370	420

WELL LOCATION:
sec. 6 T 6 N R 18 E
2 miles W of Pic
(distance) (direction) (nearest town)

WELL PURPOSE: Home
(home, irrigation, municipal, industrial)

- WELL COMPLETION DATA:
- (1) diameter (inches) 2 1/2
 - (2) total depth (feet) 420
 - (3) static water level (feet) 6 below above top of ground.
 - (4) casing Galv. 4 1/2
(material) (depth)
If telescope see back.
 - (5) screen 2 x 10 4 1/2
(length) (depth to top)
2 x 10 S.S. no. 12
(size) (material)
 - (6) pump 1/2 420
(HP) (yield gpm)
electric
(type power)
 - (7) electric log no
(yes or no)
 - (organization running log)
 - (8) how well bottom plugged
Sand Shale

CODED

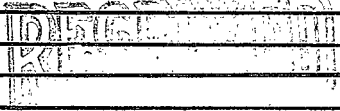


JAN 7 1974

DRILLERS REMARKS:

If well telescopes please sketch and show depths.

GROUND LEVEL

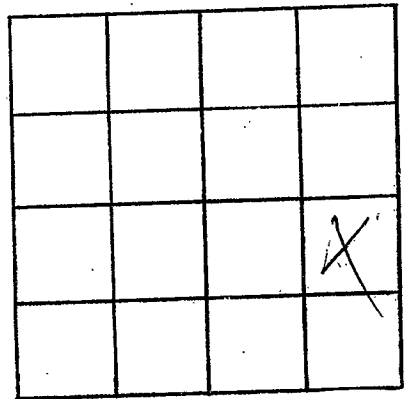

SECTION _____

Please indicate well location X.

ADDITIONAL INFORMATION

If more than one screen, show locations of each on sketch.