

P.R.
 W 135
 12-73

MISSISSIPPI
 BOARD OF WATER COMMISSIONERS
 416 North State Street
 Jackson, Mississippi 39201

CODED

WATER WELL DRILLERS LOG

Bud Lenton & Son Pearl River

date well completed 19 _____ firm name _____ county well located _____

LANDOWNER: *J.T. Lenoir*
Beaumont, Miss.

description of formations encountered	from	to
<i>Red Shale</i>	<i>0</i>	<i>9</i>
<i>Sand & rock</i>	<i>9</i>	<i>20</i>
<i>Blue shale</i>	<i>20</i>	<i>300</i>
<i>Gray sand</i>	<i>300</i>	<i>330</i>

(mailing address)

WELL LOCATION:
 sec. *10* T. *6* N. R. *18* E.
2 miles *W* of *Pic.*
 (distance) (direction) (nearest town)

WELL PURPOSE: *Home*
 (home, irrigation, municipal, industrial)

WELL COMPLETION DATA:

- (1) diameter (inches) *2 1/2*
- (2) total depth (feet) *330*
- (3) static water level (feet) *8* below above top of ground.
- (4) casing *Galv. 3 1/2*
 (material) (depth)

CODED

_____ if telescope see back.
 (size)

- (5) screen *2 1/2*, *3 1/2*
 (length) (depth to top)
2 1/2, *S.S. 10-12*
 (size) (material)


- (6) pump *1/2* *430*
 (HP) (yield gpm)
electric
 (type power)

- (7) electric log *no*
 (yes or no)

_____ (organization running log)

- (8) how well bottom plugged
Sand Shale


DRILLERS REMARKS: _____

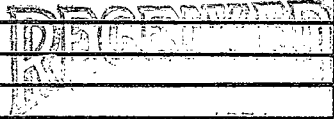

JAN 7 1974

If well telescopes please sketch and show depths.

GROUND LEVEL

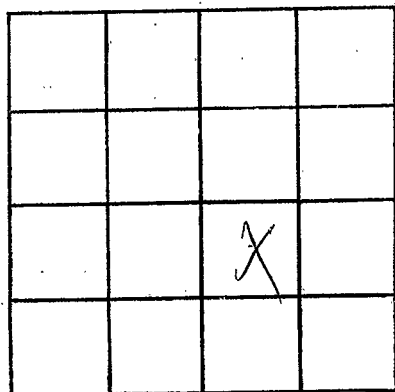

SECTION _____

Please indicate well location X.

ADDITIONAL INFORMATION

If more than one screen,
show locations of each on sketch.