

P.R.
 W 137
 5-18-74

MISSISSIPPI
 BOARD OF WATER COMMISSIONERS
 416 North State Street
 Jackson, Mississippi 39201

WATER WELL DRILLERS LOG CODED

5-18 1974 London Well Serv. Pearl River
 date well completed firm name county well located

LANDOWNER: Houston Givens
RT
Picayune, Miss.
 (mailing address)

description of formations encountered	from	to
Surface Clay	0	20
Sand	20	95
Blue Clay	95	420
Sand	420	482

WELL LOCATION:
 sec. 27 T. 7 S. R. 17 W.
1/2 miles South of Picayune
 (distance) (direction) (nearest town)

WELL PURPOSE: Home
 (home, irrigation, municipal, industrial)

WELL COMPLETION DATA:

(1) diameter (inches) 2

(2) total depth (feet) 482

(3) static water level (feet) 19 below top of ground.

(4) casing Galv. 472
 (material) (depth)
2 If telescope see back.
 (size)

(5) screen 10' 472
 (length) (depth to top)
2 S. Steel
 (size) (material)

(6) pump
 (HP) (yield gpm)

 (type power)

(7) electric log NO
 (yes or no)

(organization running log)

(8) how well bottom plugged Auto Valve

CODED


RECEIVED
 JUN 10 1974

DRILLERS REMARKS:

MISS. Bd. of WATER COMM.

If well telescopes please sketch and show depths.

GROUND LEVEL

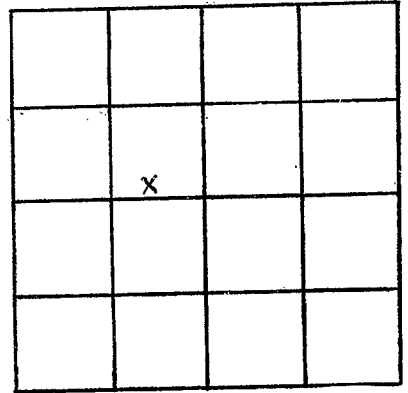

SECTION 27

Please indicate well location X.

ADDITIONAL INFORMATION

If more than one screen, show locations of each on sketch.