

Pearl River
W 139
6-27-75

MISSISSIPPI
 BOARD OF WATER COMMISSIONERS
 416 North State Street
 Jackson, Mississippi 39201

WATER WELL DRILLERS LOG

CODED

6-27- 1975 Lumpkin Well Ser. Pearl River
 date well completed firm name county well located

LANDOWNER:
Mr. Herman Dausley
Carriere, Mrs.
 (mailing address)

description of formations encountered	from	to
Clay	0	30
Sand	30	100
Clay	100	240
Sand	240	300

WELL LOCATION:
 sec 3 T N R 13 E
3 1/2 miles N of Pearl River
 (distance) (direction) (nearest town)

WELL PURPOSE: Home
 (home, irrigation, municipal, industrial)

- WELL COMPLETION DATA:
- (1) diameter (inches) 9"
 - (2) total depth (feet) 300'
 - (3) static water level (feet) 65' below top of ground.
 - (4) casing Gal., 294'
 (material) (depth)
2" if telescope see back.
 (size)
 - (5) screen 6", 294'
 (length) (depth to top)
2", Stainless Steel
 (size) (material)
 - (6) pump 1, 300
 (HP) (yield gpm)
Elec.
 (type power)
 - (7) electric log No
 (yes or no)
No
 (organization running log)
 - (8) how well bottom plugged Shut Shaft


RECEIVED
 RECEIVED

JUN 14 1975

DRILLERS REMARKS:

If well telescopes please sketch and show depths.

GROUND LEVEL

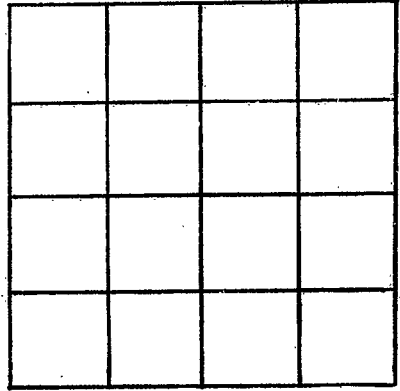

SECTION _____

Please indicate well location X.

ADDITIONAL INFORMATION

If more than one screen, show locations of each on sketch.