

Pearl River
W 140
7-3-75

MISSISSIPPI
 BOARD OF WATER COMMISSIONERS
 416 North State Street
 Jackson, Mississippi 39201

CODED

WATER WELL DRILLERS LOG

7-3 1975 Penion Well Serv Pearl River
 date well completed firm name county well located

LANDOWNER: Millicent Tardo
3417 Jacob Dr
Chalmette La-70043
 (mailing address)

description of formations encountered	from	to
Surface Clay	0	36
Sand	36	100
Blue Clay	100	200
Sand	200	250


WELL LOCATION:
 sec. 30 T. 6 S. R. 17 W.
1/2 miles SW of Picayune
 (distance) (direction) (nearest town)

WELL PURPOSE: Home
 (home, irrigation, municipal, industrial)

- WELL COMPLETION DATA:
- (1) diameter (inches) 2
 - (2) total depth (feet) 250
 - (3) static water level (feet) 21 below/above top of ground.
 - (4) casing Galv. 240
 (material) (depth)
2 if telescope see back.
 (size)
 - (5) screen 10' 240
 (length) (depth to top)
2 S. Steel
 (size) (material)
 - (6) pump 1/2 7
 (HP) (yield gpm)
Elec
 (type power)
 - (7) electric log No
 (yes or no)

(organization running log)
 (8) how well bottom plugged B.W. Valve


DRILLERS REMARKS:

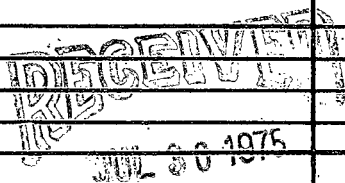

MISS. BD. OF WATER COMMISSIONERS

If well telescopes please sketch and show depths.

GROUND LEVEL

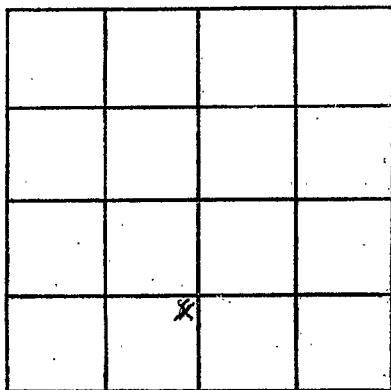

SECTION 30

Please indicate well location X.

ADDITIONAL INFORMATION

If more than one screen, show locations of each on sketch.