

Pearl River
 W 142
 3-67

MISSISSIPPI
 BOARD OF WATER COMMISSIONERS
 416 North State Street
 Jackson, Mississippi 39201

13v

CODED

WATER WELL DRILLERS LOG

3-19 date well completed 1967 Pontons Well Serv firm name Pearl River county well located

LANDOWNER: Paul Trexler

Rt 2 Box 146

Picayune MISS
 (mailing address)

WELL LOCATION:

sec. 2 T 6 S R 18 W
 5 miles NW of Picayune
 (distance) (direction) (nearest town)

WELL PURPOSE: irrigation
 (home, irrigation, municipal, industrial)

WELL COMPLETION DATA:

- (1) diameter (inches) 2
- (2) total depth (feet) 840
- (3) static water level (feet) +40 above top of ground.
- (4) casing Black Steel 820'
 (material) (depth)

 if telescope see back.
 (size)

- (5) screen 20 820'
 (length) (depth to top)

.012-.015 2" S. steel
 (size) (material)

- (6) pump
 (HP) (yield gpm)

 (type power)

- (7) electric log NO
 (yes or no)


 (organization running log)

- (8) how well bottom plugged BW Valve

DRILLERS REMARKS:

description of formations encountered	from	to
Surface Clay	0	16
Sand & Gravel	16	46
Blue Clay	46	54
Sand & Gravel	54	76
Blue Clay	76	94
Grey Sand	94	206
Blue Clay	206	240
Grey Sand	240	332
Blue Clay	332	370
Grey Sand	370	425
Blue Clay	425	520
Grey Sand	520	550
Blue Clay	550	597
Blue Clay	 	
Grey Sand	597	630
Blue Clay	630	770
Grey Sand	770	840

CODED

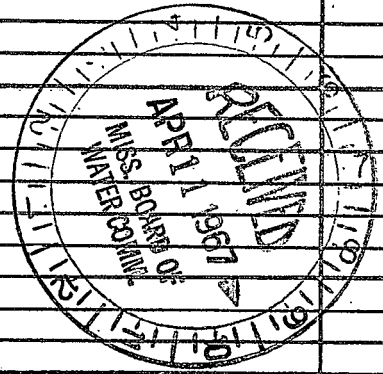

If well telescopes please sketch and show depths.

GROUND LEVEL

X			

SECTION 2

Please indicate well location X.

ADDITIONAL INFORMATION

If more than one screen,
show locations of each on sketch.