

Pearl R.
W 143
4-24-62 131

MISSISSIPPI BOARD OF WATER COMMISSIONERS

WATER WELL DRILLERS LOG

Date: 4-24-62, 1962, Driller: Butler Well Wks. County Pearl River
(Name)

CODED

(1) Owner of Land: Jay Warren
(Name)
Picayune, Miss
(Address)

(2) Location: SE 1/4, SE 1/4, Sec. 4 T13R17W
1 miles S of Nicholson
(distance) (direction) (Nearest Town)

(3) Topography: hilly
(Hilly) (Flat) (Level)

(4) Purpose of Well: domestic
(Domestic Irrigation
Municipal, Industrial, Other)

Description & Color of Materials Sand, Clay, Red Clay, Shell, etc.	Thick- ness Feet	Depth Feet
Clay	18	18
Sand & gravel	87	105
Clay	115	220
Sand	95	315
Clay	110	425
Sand	110	535
Clay	35	570
Sand	60	630
Clay	190	840
Sand	40	880
Clay	30	910
		940
Sand	60	970

Information upon completion of well:

(1) Diameter 2 inches.

(2) Total Depth 970 feet.

(3) Water Level +50 feet above below top of ground.


(4) Cased to all, Size 2"

(5) Screen: Size 2", Length 20'

(6) Were any formations sealed against pollution?
_____ yes, no.

If YES depth of formation _____
Why _____

Drillers Remarks: _____

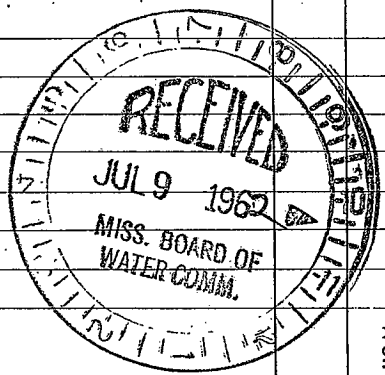

(Use Back Side)

Well No.

Retain this copy for your office files.

