

Pearl River

MISSISSIPPI BOARD OF WATER COMMISSIONERS

W 146

9-66

131 WATER WELL DRILLERS LOG

Date: 9-30, 1966, Driller: Walter Peniston **CODED** County Pearl River

(Name)

(1) Owner of Land: Nicholson Baptist Church

(Name)

Nicholson, Miss

(Address)

(2) Location: NW 1/4, NE 1/4, Sec. 38 T6 R17 W

0 miles West Nicholson

(distance)

(direction)

(Nearest Town)

(3) Topography: Flat

(Hilly)

(Flat)

(Level)

(4) Purpose of Well: Domestic

(Domestic Irrigation  
Municipal, Industrial, Other)

Description & Color of Materials  
Sand, Clay, Red Clay, Shell, etc.

Thick-  
ness  
Feet

Depth  
Feet

Clay	38	0-38
Sand & Gravel	78	116
Blue Clay	129	245
Grey sand	95	340
Blue Clay	83	423
Grey sand	105	527
Blue Clay	89	616
Grey sand	22	638
Blue Clay	244	882
Grey sand	65	947

Information upon completion of well:

(1) Diameter 2 inches.

(2) Total Depth 947 feet.

(3) Water Level flow feet below top of ground.

(4) Cased to 927, Size 2"

(5) Screen: Size 2" 1012, Length 20'


(6) Were any formations sealed against pollution?

yes, no.

If YES depth of formation

Why

Drillers Remarks:

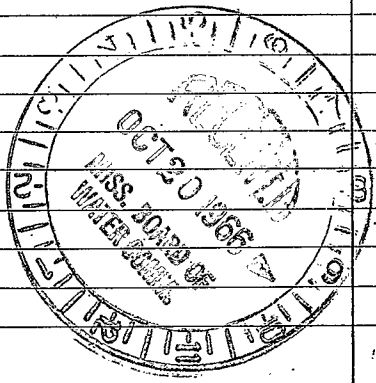

(Use Back Side)

Well No.

