

Pearl River

W 147 131

10-66 MISSISSIPPI BOARD OF WATER COMMISSIONERS

CODED

WATER WELL DRILLERS LOG

Date: 10-1, 1966, Driller: Neil Lumpkin County Pearl River

(When well drilled)

(Name)

(Where well is located)

1) Owner of Land: Robert Koch  
(Name)  
Picayune, Miss.

2) Location: NW 17 17  
NE 1/4, NE 1/4, Sec 38 T7S R18W  
3 miles west of Picayune  
(distance) (direction) (Nearest Town)

3) Topography: level  
(Hilly) (Flat) (Level)

4) Purpose of Well: Domestic  
(Domestic Irrigation  
Municipal, Industrial, Other)

Description & Color of Materials Sand, Clay, Red Clay, Shell, etc.	Thick- ness Feet	Depth Feet
surface clay	10	10
" sand	70	80
blue clay	155	235
good sand	165	400
blue clay	180	580
good sand	50	630
blue clay	195	825
good sand	83	908

CODED

Information upon completion of well:

1) Diameter 2 inches.

2) Total Depth 908 feet.

3) Water Level \_\_\_\_\_ feet below top of ground.

4) Cased to \_\_\_\_\_, Size \_\_\_\_\_.

5) Screen: Size 2" SS, Length 20.

6) Were any formations sealed against pollution?  
\_\_\_\_\_ yes,  no.

YES depth of formation \_\_\_\_\_


Why \_\_\_\_\_

Drillers Remarks: \_\_\_\_\_

Yield in gpm: 50 gal. per min.

Size pump: Fisher

Type power: \_\_\_\_\_

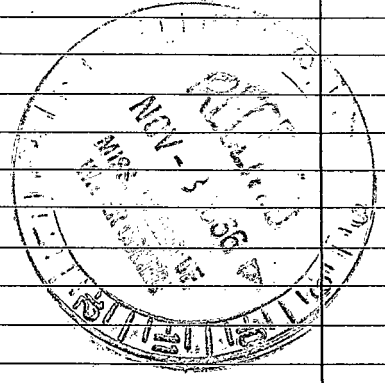

File this copy to Board of Water Commissioners 429 Miss. St. Jackson, Miss.

