

Pearl River
 W 149
 3-67

MISSISSIPPI
 BOARD OF WATER COMMISSIONERS
 416 North State Street
 Jackson, Mississippi 39201

CODED

WATER WELL DRILLERS LOG

3-28 1967 date well completed
 67 Penlon Well Serv firm name
 Pearl River county well located

LANDOWNER: Jim B. Harrelson

Rt 4 Box 200A

Picayune MISS
 (mailing address)

WELL LOCATION:

sec. 9 T 6 S R 17 W
 0 miles west of Picayune
 (distance) (direction) (nearest town)


WELL PURPOSE: Home
 (home, irrigation, municipal, industrial)

WELL COMPLETION DATA:

- (1) diameter (inches) 2"
- (2) total depth (feet) 1175
- (3) static water level (feet) 40' (above top of ground) + 42'
- (4) casing Black Steel 1155'
 (material) (depth)
 if telescope see back.
 (size)
- (5) screen 20' 1155'
 (length) (depth to top)
 012 2" S. steel
 (size) (material)
- (6) pump L
 (HP) (yield gpm)
 (type power)
- (7) electric log NO
 (yes or no)
 (organization running log)
- (8) how well bottom plugged BW Value

description of formations encountered	from	to
Surface clay	0	48
Sand + Gravel	48	90
Blue clay	90	105
Green sand	105	128
Blue clay	128	162
Grey sand	162	260
Blue clay	260	346
Grey sand	346	440
Blue clay	440	752
Grey sand	752	768
Blue clay	768	798
Grey sand	798	875
Blue clay	875	892
Grey sand	892	936
Blue clay	936	1040
Grey sand	1040	1175


CODED

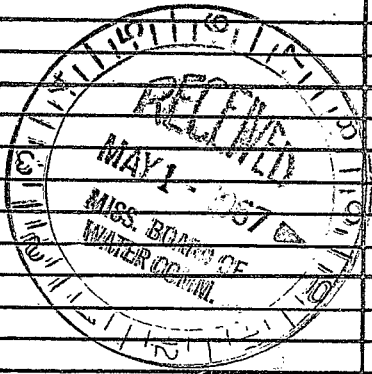

DRILLERS REMARKS: 18 lbs. shut in Pressure at ground level. Static water level est.

If well telescopes please sketch and show depths.

GROUND LEVEL

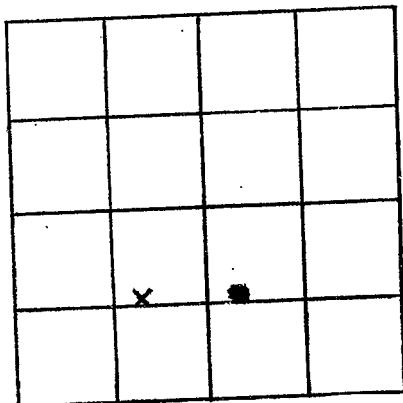

SECTION 9

Please indicate well location X.

ADDITIONAL INFORMATION

If more than one screen, show locations of each on sketch.