

Pearl River  
 W 150  
 6-67

MISSISSIPPI  
 BOARD OF WATER COMMISSIONERS  
 416 North State Street  
 Jackson, Mississippi 39201

CODED

WATER WELL DRILLERS LOG

6-3 1967 Ponton Well Serv Pearl River  
 date well completed firm name county well located

LANDOWNER: Leroy Seal  
 Rt. 1 Box 44  
 Picayune, Miss  
 (mailing address)


WELL LOCATION:  
 sec. 39 T 6 S R 17 W  
 0 miles West of Nicholson  
 (distance) (direction) (nearest town)

WELL PURPOSE: Home  
 (home, irrigation, municipal, industrial)

WELL COMPLETION DATA:

(1) diameter (inches) 5" Drilled  
 (2) total depth (feet) 1244  
 (3) static water level (feet) 167.2 above top of ground. 156  
 (4) casing steel 1224  
 (material) (depth)  
 2" If telescope see back.  
 (size)  
 (5) screen 20' 1224  
 (length) (depth to top)  
 2" S. Steel  
 (size) (material)  
 (6) pump NO  
 (HP) (yield gpm)  
 (type power)  
 (7) electric log NO  
 (yes or no)  
 (organization running log)  
 (8) how well bottom plugged B.W. Valve


description of formations encountered	from	to
Clay	0	28
Sand + Gravel	28	110
Blue clay	110	120
Green Blue sand	120	268
Blue clay	268	305
Grey sand	305	335
Blue clay	335	420
Grey sand	420	505
Blue clay	505	890
Grey sand	890	957
Blue clay	957	1160
Grey sand	1160	1244

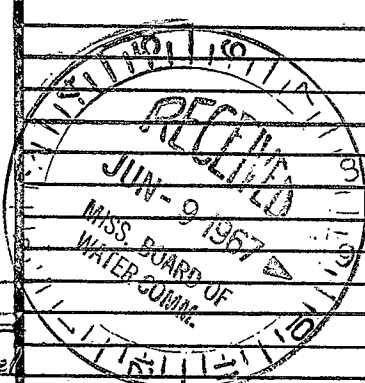

DRILLERS REMARKS: Water level based on 2.8 feet per Pound Pressure at Ground Level - 24 lbs Pressure at Ground Level

If well telescopes please sketch and show depths.

GROUND LEVEL

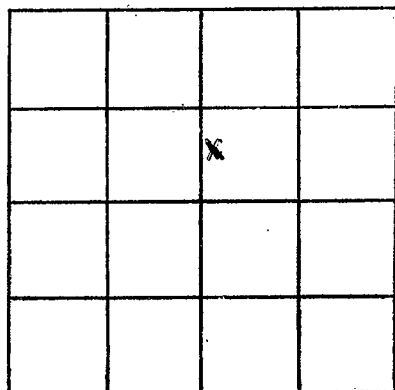

SECTION 39

Please indicate well location X.

ADDITIONAL INFORMATION

If more than one screen,  
show locations of each on sketch.