

Pearl River
W 151
9-67

MISSISSIPPI
 BOARD OF WATER COMMISSIONERS
 416 North State Street
 Jackson, Mississippi 39201

130

CODED

WATER WELL DRILLERS LOG

9-14 19 Penton Well Serv Pearl River
 date well completed firm name county well located

LANDOWNER: J.W. Brumfield

Rt. 4, Box 506

Picayune, Miss
 (mailing address)

WELL LOCATION:

28 sec. 28 T. 6 S R. 17 W
1/2 miles SW of Picayune
 (distance) (direction) (nearest town)

WELL PURPOSE: None
 (home, irrigation, municipal, industrial)

WELL COMPLETION DATA:

(1) diameter (inches) 4 1/2 Drilled

(2) total depth (feet) 957'

(3) static water level (feet) 47.6 above
 top of ground. +39'

(4) casing Black steel 937'
 (material) (depth)

2"
 (size) if telescope see back.

(5) screen 20', 937'
 (length) (depth to top)

.012-015 2", S steel
 (size) (material)

(6) pump NO
 (HP) (yield gpm)

(type power)

(7) electric log NO
 (yes or no)

(organization running log)


(8) how well bottom plugged B.W. Valve

description of formations encountered

from to

Clay	0	33
Sand + Gravel	33	85
Blue Clay	85	258
Grey Sand	258	270
Blue Clay	270	360
Fine Grey Sand	360	368
Blue Clay	368	470
Grey Sand	470	505
Blue Clay	505	727
Grey Sand	727	762
Blue Clay	762	910
Grey Sand	910	957

CODED

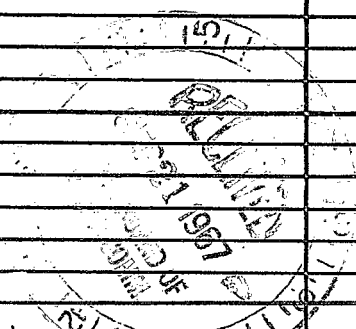

DRILLERS REMARKS: 17 lbs. Shut in Pressure at Ground level

Did NOT go to Bottom of sand

If well telescopes please sketch and show depths.

GROUND LEVEL

			X

SECTION 28

Please indicate well location X.

ADDITIONAL INFORMATION

If more than one screen, show locations of each on sketch.