

PEARL RIVER  
 W 153  
 S-68

MISSISSIPPI  
 BOARD OF WATER COMMISSIONERS  
 416 North State Street  
 Jackson, Mississippi 39201

WATER WELL DRILLERS LOG

CODED

5-17 1968 Penton Well Serv Pearl River  
 date well completed firm name county well located

LANDOWNER: D.B. Temple

712 S. Hough St

Picayune Miss  
 (mailing address)

WELL LOCATION:

sec. 27 T. 8 S. R. 17 W.  
1/2 miles South of Picayune  
 (distance) (direction) (nearest town)

WELL PURPOSE: Home  
 (home, irrigation, municipal, industrial)

WELL COMPLETION DATA: 4 1/2 Drilled


- (1) diameter (inches) 2"
- (2) total depth (feet) 950
- (3) static water level (feet) Flow <sup>124</sup> below top of ground. above
- (4) casing Black S., 930  
 (material) (depth)  
2" If telescope see back.  
 (size)
- (5) screen 20', 930  
 (length) (depth to top)  
2", S. Steel  
 (size) (material)
- (6) pump  (HP) \_\_\_\_\_ (yield gpm)  
 \_\_\_\_\_ (type power)
- (7) electric log NO  
 (yes or no)  
 \_\_\_\_\_ (organization running log)
- (8) how well bottom plugged B.W. Valve

description of formations encountered

from to


Clay	0	28
Sand	28	105
Blue Clay	105	140
" Sand	140	152
Blue Clay	152	360
Clay + sand	360	435
Grey sand	435	495
Blue Clay	495	722
Grey sand	722	765
Blue Clay	765	888
Grey Sand	888	950

DRILLERS REMARKS: 16 lbs  
shatin Pressure  
at 1 ft. above Ground

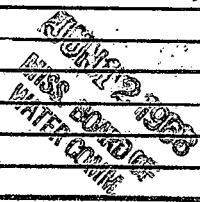

If well telescopes please sketch and show depths.

GROUND LEVEL

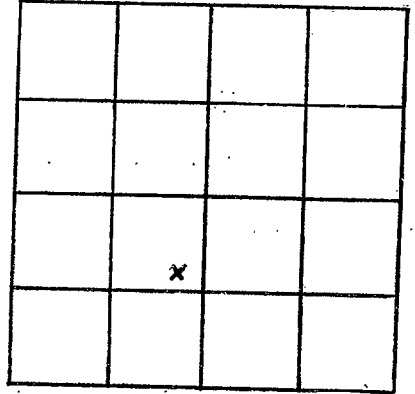

SECTION 27

Please indicate well location X.

ADDITIONAL INFORMATION

If more than one screen,  
show locations of each on sketch.