

Pearl River
 W 155
 6-68

MISSISSIPPI
 BOARD OF WATER COMMISSIONERS
 416 North State Street
 Jackson, Mississippi 39201 **CODED**

WATER WELL DRILLERS LOG

6-12 1968 Penton Well Serv Pearl River
 date well completed firm name county well located

LANDOWNER: Jack Stockstill
 Rt. 4 Box 211
 Picayune Miss.
 (mailing address)

description of formations encountered	from	to
Red Clay	0	8
Sand + Gravel	8	55
Blue Clay	55	257
Grey Sand	257	355
Blue Clay	355	367
Grey Sand	367	452
Blue Clay	452	595
Grey Sand	595	618
Blue Clay	618	720
Blue Mud	720	765
Fine Sand	765	783
Blue Clay	783	820
Grey Sand	820	908


WELL LOCATION:
 sec. 28 T 6 S R 17 W
 2 miles West of Picayune
 (distance) (direction) (nearest town)

WELL PURPOSE: Home
 (home, irrigation, municipal, industrial)

WELL COMPLETION DATA: 5" Drilled

- (1) diameter (inches) 2"
- (2) total depth (feet) 902
- (3) static water level (feet) Flow above top of ground. 136
- (4) casing Black S. 882'
 (material) (depth)
 2" If telescope see back.
 (size)
- (5) screen 20' 882'
 (length) (depth to top)
 2" S. Steel
 (size) (material)
- (6) pump 65
 (HP) (yield gpm)
 (type power)
- (7) electric log NO
 (yes or no)
 (organization running log)
- (8) how well bottom plugged BW Valve


CODED

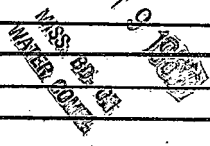

DRILLERS REMARKS: 22 lbs
 Pressure 2 ft above
 Ground level

If well telescopes please sketch and show depths.

GROUND LEVEL

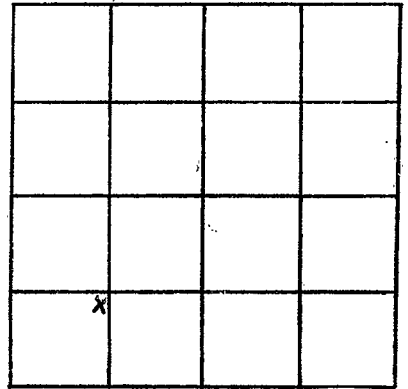

SECTION 28

Please indicate well location X.

ADDITIONAL INFORMATION

If more than one screen,
show locations of each on sketch.