

PEARL RIVER
 W 157
 11-24-75

MISSISSIPPI
 BOARD OF WATER COMMISSIONERS
 416 North State Street
 Jackson, Mississippi 39201

WATER WELL DRILLERS LOG

11/24/75 date well completed 1975 Bud ~~Porter~~ Porter & Son firm name Pearl River county well located

LANDOWNER: Joe Seal
Raymond Moss

description of formations encountered	from	to
white shale	0	16
white sandstone	16	150
blue shale	150	200
blue sand	200	320
blue shale	320	370
blue sand	370	380
blue shale	380	400
blue sand	400	450
blue shale	450	573
blue sand	573	628

(mailing address)


WELL LOCATION:
 sec. 33 T. 6 N. R. 17 E.
 4.31 miles (distance) S of Raymond Moss (direction) of Raymond Moss (nearest town)

WELL PURPOSE: home
 (home, irrigation, municipal, industrial)

WELL COMPLETION DATA:

- (1) diameter (inches) 2"
- (2) total depth (feet) 1628
- (3) static water level (feet) 26 ^{below} above top of ground.
- (4) casing: Galv. (material) 1628 (depth)
2" (size) if telescope see back.
- (5) screen: 40 (length) 1588 (depth to top)
12 (size) Galv. (material)
- (6) pump: no (HP) (yield gpm)
no (type power)
- (7) electric log no (yes or no)
- (organization running log)
- (8) how well bottom plugged Sand pack


DRILLERS REMARKS:

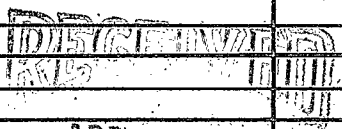

APR 12 1976

If well telescopes please sketch and show depths.

GROUND LEVEL

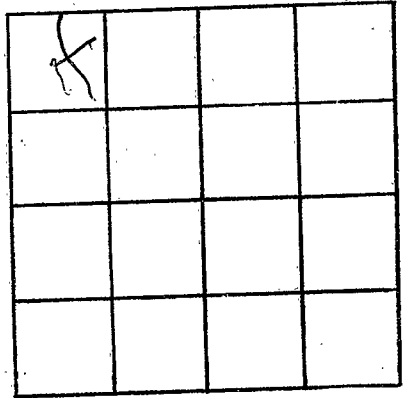

SECTION _____

Please indicate well location X.

ADDITIONAL INFORMATION

If more than one screen, show locations of each on sketch.