

**MISSISSIPPI
BOARD OF WATER COMMISSIONERS**
416 North State Street
Jackson, Mississippi 39201

WATER WELL DRILLERS LOG

| |
|-------------|
| Pearl River |
| W 158 |
| 7-1-75 |

13V

7/1 1975 Bud Pinton & Son Pearl River
 date well completed firm name county well located

LANDOWNER: Roy affard

R.T. 2 Picoyune
 miss.
 (mailing address)

| description of formations encountered | from | to |
|---------------------------------------|------|-----|
| white shale | 0 | 38 |
| white sand | 38 | 150 |
| blue shale | 150 | 275 |
| gray sand | 275 | 352 |
| blue shale | 352 | 691 |
| gray sand | 691 | 780 |

WELL LOCATION:

sec. 6 T. 6 N. R. 10 E.
 2 miles West of Picoyune
 (distance) (direction) (nearest town)

WELL PURPOSE: home
 (home, irrigation, municipal, industrial)

WELL COMPLETION DATA:


- (1) diameter (inches) 2"
- (2) total depth (feet) 780
- (3) static water level (feet) 106 ^{below} top of ground.
- (4) casing Nov. 780
 (material) (depth)
- (size) if telescope see back.
- (5) screen 2x20, 760
 (length) (depth to top)
- 12, S.S. Steel
 (size) (material)
- (6) pump no
 (HP) (yield gpm)
- (type power)
- (7) electric log no
 (yes or no)
- (organization running log)
- (8) how well bottom plugged hard

DRILLERS REMARKS:

MISS. Bd. OF WATER COMMISSIONERS

If well telescopes please sketch and show depths.

GROUND LEVEL

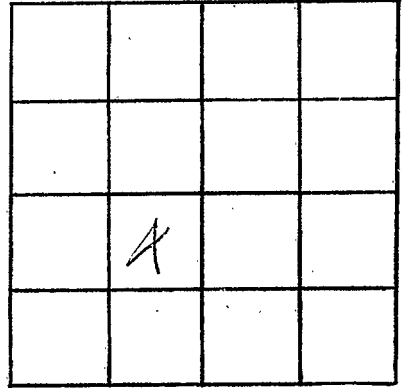

SECTION _____

Please indicate well location X.

ADDITIONAL INFORMATION

If more than one screen, show locations of each on sketch.