

PEARL R.

W160

3-77

EL# 115

MAR

MISSISSIPPI BOARD OF WATER COMMISSIONERS 416 North State Street Jackson, Mississippi 39201

CODED

WATER WELL DRILLERS LOG

date well completed

firm name

county well located

LANDOWNER: NICHOLSON

WATER ASSOC. WELL No. 1

(mailing address)

WELL LOCATION:

sec. 39 T. 6 N R. 17 E FR. SE COR OF 37 (S) GO 1550 ft. S. & 500 ft. W, at RA 70 LOC. (distance) miles (direction) of (nearest town)

WELL PURPOSE:

(home, irrigation, municipal, industrial)

WELL COMPLETION DATA:

- (1) diameter (inches) 10 3/4
(2) total depth (feet) 490
(3) static water level (feet) 1850 below top of ground
(4) casing B.I. 430 (material) (depth)
(5) screen 50 440 (length) (depth to top)
(6) pump 30 400 (HP) (yield-gpm)
(7) electric log yes
(8) how well bottom plugged BACK

description of formations encountered

from to

Table with 3 columns: description of formations encountered, from, to. Rows include: SURFACE SAND (0-3), CLAY (3-22), SAND & CLAY streaks (22-50), SAND (50-102), CLAY (102-150), SAND (150-242), SAND w/ CLAY streaks (242-334), CLAY (334-424), SAND (424-526), CLAY (526-528)

CODED


DRILLERS REMARKS:

MAR 8 1977

MISS. Bd. OF WATER COMMISSIONERS

If well telescopes please sketch and show depths.

GROUND LEVEL

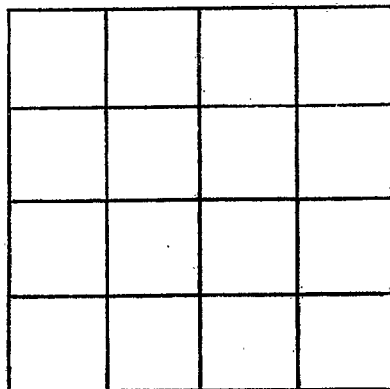

SECTION _____

Please indicate well location X.

ADDITIONAL INFORMATION

If more than one screen, show locations of each on sketch.