

Pearl R  
W 161  
1-27-77

MISSISSIPPI  
BOARD OF WATER COMMISSIONERS  
416 North State Street  
Jackson, Mississippi 39201

CODED

WATER WELL DRILLERS LOG

1-27 1977 Bud Benton & Son Pearl River  
date well completed firm name county well located

LANDOWNER:  
Belton Watts  
Bicayne, Miss  
(mailing address)

WELL LOCATION:  
sec. 3 T. 6 N. R. 17 E.  
1 1/2 miles NW of Bicayne  
(distance) (direction) (nearest town)

WELL PURPOSE: Home  
(home, irrigation, municipal, industrial)

WELL COMPLETION DATA:  
(1) diameter (inches) 2 in  
(2) total depth (feet) 1165 1135  
(3) static water level (feet) 17 1/2 below above top of ground.  
(4) casing Galv. 1135  
(material) (depth)  
(size) If telescope see back.  
(5) screen 30 1135  
(length) (depth to top)  
2 in. S. Steel  
(size) (material)  
(6) pump 17 1/2 hp.  
(HP) (yield gpm)  
(type power)  
(7) electric log No  
(yes or no)

(organization running log)  
(8) how well bottom plugged  
Sand Shank

DRILLERS REMARKS:


description of formations encountered	from	to
white shale	0	31
white sand	31	78
Blue shale	78	420
Gray sand	420	475
Blue shale	475	786
Blue sand	786	1075
Blue shale	1075	1135
Gray sand	1135	

CODED

RECEIVED  
APR 15 1977

If well telescopes please sketch and show depths.

GROUND LEVEL

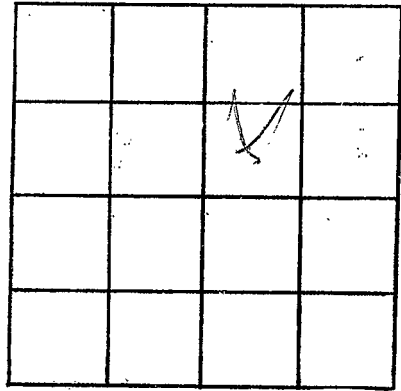

SECTION \_\_\_\_\_

Please indicate well location X.

ADDITIONAL INFORMATION

Lined area for additional information.

If more than one screen, show locations of each on sketch.