

Pearl River
 W 162
 10-12-77

MISSISSIPPI
 BOARD OF WATER COMMISSIONERS
 416 North State Street
 Jackson, Mississippi 39201

CODED

WATER WELL DRILLERS LOG

10-12-77 19 Penton Well Serv Pearl River
 date well completed firm name county well located

LANDOWNER: M. D. TATE

Picayune, Ms.
 (mailing address)

WELL LOCATION:
 sec. 1 T. 6 N R. 17 E
 S W
 1 miles North of Picayune
 (distance) (direction) (nearest town)

WELL PURPOSE: Home
 (home, irrigation, municipal, industrial)

WELL COMPLETION DATA:
 (1) diameter (inches) 2"
 (2) total depth (feet) 1028'
 (3) static water level (feet) Flow below above top of ground.
 (4) casing GALV, 1008 (material), (depth)
 2" (size) If telescope see back.
 (5) screen 20, 1008 (length), (depth to top)
 2" S. Steel (size), (material)
 (6) pump (HP) (yield gpm)
 (type power)
 (7) electric log No (yes or no)
 (organization running log)
 (8) how well bottom plugged B.W. WAL

description of formations encountered	from	to
CLAY	0	20
SAND+GRAVEL	20	40
Blue CLAY	40	465
SAND	465	520
Blue CLAY	520	930
SAND	930	1028

CODED


RECEIVED

NOV - 4 1977

DRILLERS REMARKS:

If well telescopes please sketch and show depths.

GROUND LEVEL

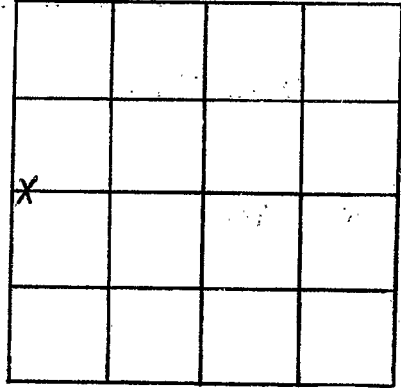

SECTION 1

Please indicate well location X.

ADDITIONAL INFORMATION

A series of horizontal lines for writing additional information, located below the 'ADDITIONAL INFORMATION' header.

If more than one screen, show locations of each on sketch.