

Pearl River
 W 164
 12-9-77

MISSISSIPPI
 BOARD OF WATER COMMISSIONERS
 416 North State Street
 Jackson, Mississippi 39201

CODED

WATER WELL DRILLERS LOG

12-9-77 19 date well completed PenTOn Well Serv. firm name Pearl River county well located

LANDOWNER: Joe Godwin
 Picayune, Ms.
 (mailing address)
 WELL LOCATION:
 sec. 3 T. 6 R. 17
 S W E
1/2 miles North of Picayune
 (distance) (direction) (nearest town)

description of formations encountered	from	to
Surface Sand	0	10
Sand + Gravel	10	55
Blue Clay	55	250
Sand	250	345
Blue Clay	345	400
Sand	400	435
Blue Clay	435	530
Sand	530	760
Blue Clay	760	940
Sand	940	1050

WELL PURPOSE: Home
 (home, irrigation, municipal, industrial)

WELL COMPLETION DATA:
 (1) diameter (inches) 3"
 (2) total depth (feet) 1028'
 (3) static water level (feet) Flow below above top of ground.
 (4) casing Black, 1008'
 (material) (depth)
3"
 (size) if telescope see back.
 (5) screen 20', 1008'
 (length) (depth to top)
3", S. Steel
 (size) (material)
 (6) pump ✓, 100
 (HP) (yield gpm)
 (type power)
 (7) electric log NO
 (yes or no)
 (organization running log)
 (8) how well bottom plugged B.W. Valve


DRILLERS REMARKS:

RECEIVED
 DEC 27 1977

MISS. BD. OF WATER COMMISSIONERS

If well telescopes please sketch and show depths.

GROUND LEVEL

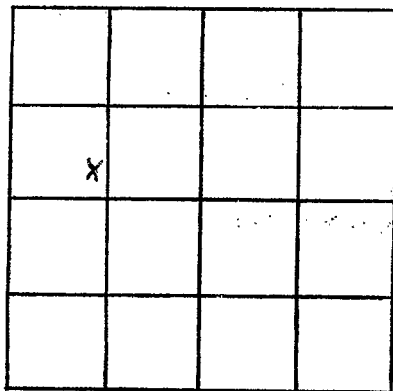

SECTION 3

Please indicate well location X.

ADDITIONAL INFORMATION

Multiple horizontal lines for writing additional information.

If more than one screen, show locations of each on sketch.