

PEARL RIVER
 W 166
 3/11/81
 3/11

MISSISSIPPI
 BOARD OF WATER COMMISSIONERS
 416 North State Street
 Jackson, Mississippi 39201



WATER WELL DRILLERS LOG

date well completed 1981
 firm name Bed Ponton Water Well Service

county Pearl River well located

LANDOWNER: Harry Mitchell
 B.T. Co PO Box
 Carriere Miss.
 (mailing address)

description of formations encountered	from	to
Red shale	0	70
White sandy	70	60
gray sand	60	320
White shale	320	710
Blue shale	710	1000
Gray sand	1000	1050

WELL LOCATION:
 sec 29 T 7 N R 17 E
 6 S 4 E
 4 miles W of Prentiss
 (distance) (direction) (nearest town)

WELL PURPOSE: home
 (home, irrigation, municipal, industrial)


- WELL COMPLETION DATA:
- (1) diameter (inches) 9"
 - (2) total depth (feet) 1050
 - (3) static water level (feet) 13 below top of ground.
 - (4) casing PVC 1050 (material) (depth)
 - (size) If telescope see back.
 - (5) screen 2x30, 1020 (length) (depth to top)
 12, PVC (size) (material)
 - (6) pump 70 HP 1400 (yield gpm)
 70 (type power)
 - (7) electric log 70 (yes or no)

(organization running log)
 (8) how well bottom plugged
 Alford
 sharp

DRILLERS REMARKS:

If well telescopes please sketch and show depths.

GROUND LEVEL

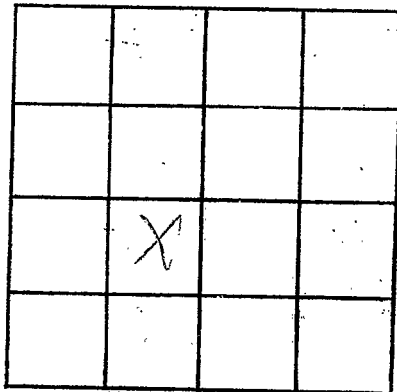

SECTION _____

Please indicate well location X.

ADDITIONAL INFORMATION

If more than one screen,
show locations of each on sketch.