

PEARL RIVER
W 167
8-24-79

MISSISSIPPI
BOARD OF WATER COMMISSIONERS
416 North State Street
Jackson, Mississippi 39201

WATER WELL DRILLERS LOG

CODED

8-24
date well completed

79 Penton Well Serv.
firm name

Pearl River
county well located

LANDOWNER: Larry Stockstill

description of formations
encountered

from

to

Rt-

Surface clay

0

40

Picayune Miss.
(mailing address)

Sand

40

110

Blue clay

110

340

Sand

340

460

Blue clay

460

650

Sand

650

734

WELL LOCATION:

sec. 17 T. 6 S. R. 17 W.

1 miles West of Picayune
(distance) (direction) (nearest town)

WELL PURPOSE: Home
(home, irrigation, municipal, industrial)

WELL COMPLETION DATA:

(1) diameter (inches) 2"

(2) total depth (feet) 734'

(3) static water level (feet) Flow below above top of ground.

(4) casing Galv 748'
(material) (depth)

2" if telescope see back.
(size)

(5) screen 20' 748'
(length) (depth to top)

2" S. Steel
(size) (material)

(6) pump (HP) (yield gpm)

(type power)

(7) electric log No
(yes or no)

(organization running log)

(8) how well bottom plugged Bw Valve


CODED

rec'd 10-2-79
Dm

DRILLERS REMARKS:

If well telescopes please sketch and show depths.

GROUND LEVEL

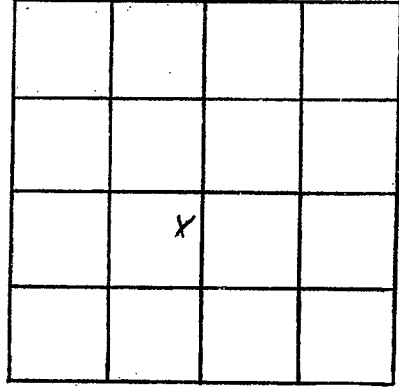

SECTION 17

Please indicate well location X.

ADDITIONAL INFORMATION

If more than one screen, show locations of each on sketch.