

Pearl River
W-168
10/3/79

MISSISSIPPI
BOARD OF WATER COMMISSIONERS
416 North State Street
Jackson, Mississippi 39201

WATER WELL DRILLERS LOG

10/30 1979 *Paul Austin* firm name *Pearl River* county well located
date well completed

LANDOWNER: *Bonnie Watkins*
P.O. 2 Jacque (mailing address)
WELL LOCATION:
sec. 29 T 7 S R. 18 W
18 miles W of Jacque
(distance) (direction) (nearest town)
WELL PURPOSE: home
(home, irrigation, municipal, industrial)

description of formations encountered	from	to
<i>white shale</i>	<i>0</i>	<i>30</i>
<i>white sand</i>	<i>30</i>	<i>125</i>
<i>blue shale</i>	<i>125</i>	<i>455</i>
<i>blue sand</i>	<i>455</i>	<i>575</i>
<i>blue shale</i>	<i>575</i>	<i>740</i>
<i>blue sand</i>	<i>740</i>	<i>830</i>
<i>blue shale</i>	<i>830</i>	<i>900</i>
<i>blue sand</i>	<i>900</i>	<i>1070</i>
<i>blue shale</i>	<i>1040</i>	<i>1075</i>
<i>gray sand</i>	<i>1075</i>	<i>1130</i>

WELL COMPLETION DATA:
(1) diameter (inches) 2"
(2) total depth (feet) 1130
(3) static water level (feet) 16 below above top of ground.
(4) casing galv. 4 1/2" (material) 110 (depth)
(size) if telescope see back.
(5) screen 20' 110 (length) (depth to top)
12" steel (size) (material)
(6) pump 750 (HP) (yield gpm)
(type power)
(7) electric log no (yes or no)
(organization running log)
(8) how well bottom plugged sand shock

DRILLERS REMARKS:


DEPT. OF NATURAL RESOURCES
BUREAU OF LAND & WATER RESOURCES

JAN 7 1980

RECEIVED

If well telescopes please sketch and show depths.

GROUND LEVEL

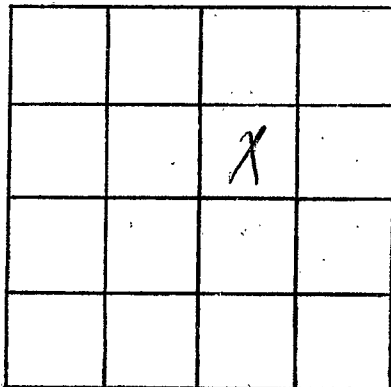

SECTION _____

Please indicate well location X.

ADDITIONAL INFORMATION

If more than one screen, show locations of each on sketch.