

MISSISSIPPI DEPARTMENT OF NATURAL RESOURCES

Bureau of Land and Water Resources

Southport Mall

P.O. Box 10631

Jackson, Mississippi 39209

WATER WELL DRILLERS LOG

CODED

Pearl River
W-170
4-19-80

4-19

1980 Lentoni Well Serv

Pearl River

date well completed

firm name

county well located

LANDOWNER: Kerry Burg

Rt.

Picayune MS.
(mailing address)

description of formations encountered

from

to

Surface Clay

0

15

Sand

15

70

Clay

70

180

Sand

180

230

Clay

230

960

1 Sand

960

1041

WELL LOCATION:

sec 24 T 6 N R 17 E
S W

0 miles SE of Picayune
(distance) (direction) (nearest town)

WELL PURPOSE: Home

(home, irrigation, municipal, industrial)

CODED

WELL COMPLETION DATA:

- (1) diameter (inches) 2
- (2) total depth (feet) 1041
- (3) static water level (feet) Flow above top of ground.

- (4) casing Galv. 1021
(material) (depth)

2 if telescope see back.
(size)

- (5) screen 20' 1021
(length) (depth to top)

2 S. Steel.
(size) (material)

- (6) pump ✓ 20
(HP) (yield gpm)

✓
(type power)

- (7) electric log No
(yes or no)

(organization running log)

- (8) how well bottom plugged Bill. Valve

DRILLERS REMARKS:

DEPT. OF NATURAL RESOURCES
BUREAU OF LAND & WATER RESOURCES


JUN 3 - 1980

RECEIVED

If well telescopes please sketch and show depths.

GROUND LEVEL

S. E. Corner of
Picayune city Limits

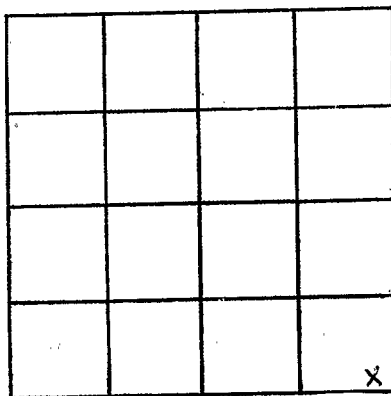

24
SECTION 1

Please indicate well location X.

ADDITIONAL INFORMATION

If more than one screen,
show locations of each on sketch.