

PEARL R.
W 171
43/80

MISSISSIPPI
BOARD OF WATER COMMISSIONERS
416 North State Street
Jackson, Mississippi 39201

CODED

WATER WELL DRILLERS LOG

6-3
date well completed

BOUNCY WATER WELL DRILLING
firm name

Pearl River
county well located

LANDOWNER: Bill Mosley
Fog's Nursery
Millbrook - Dr. P. Clayton
(mailing address)

description of formations encountered	from	to
Clay -	0	5
sd -	5	30
Clay (cut) sand	30	34
good sd -	34	48

WELL LOCATION:
sec. 1 T. 6 N. R. 17 E.
S. W.
1 miles NE of Pearl River
(distance) (direction) (nearest town)

WELL PURPOSE: IRRIGATION
(home irrigation, municipal, industrial)

WELL COMPLETION DATA:

(1) diameter (inches) 4
48

(2) total depth (feet) 48

(3) static water level (feet) 12 below
top of ground above

(4) casing PVC 43
(material) (depth)
4 If telescope see back.
(size)

(5) screen 5 43
(length) (depth to top)
4 (size) PVC (material)

(6) pump 1 35
(HP) (yield gpm)
AC 220V
(type power)

(7) electric log yes or no
(organization running log)

(8) how well bottom plugged 1

CODED

DRILLERS REMARKS: 1


DEPT. OF NATURAL RESOURCES
BUREAU OF LAND & WATER RESOURCES

JUN 25 1980

RECEIVED

If well telescopes please sketch and show depths.

GROUND LEVEL

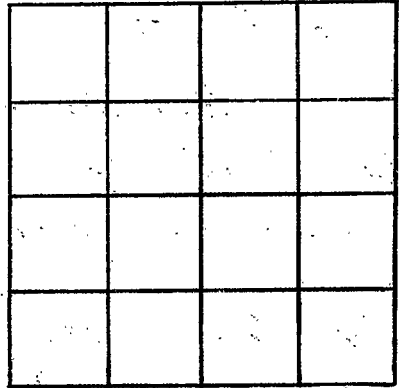

SECTION _____

Please indicate well location X.

ADDITIONAL INFORMATION

If more than one screen, show locations of each on sketch.