

~~PEARL RIVER~~

MISSISSIPPI DEPARTMENT OF NATURAL RESOURCES
Bureau of Land and Water Resources
Southport Mall
P.O. Box 10631
Jackson, Mississippi 39209
WATER WELL DRILLERS LOG

CODL

11-172
7/19/89

7-19 1980 Penton Well Serv Pearl River
date well completed firm name county well located

LANDOWNER: Marlon Stockstill
RT
Picayune MS.
(mailing address)

description of formations encountered	from	to
Surface clay	0	15
Sand	15	110
Blue clay	110	280
Sand	280	490
Blue clay	490	800
Sand	800	863

WELL LOCATION:
sec. 2 T. 6 N. R. 18 E.
S. W.
4 miles NW of Picayune
(distance) (direction) (nearest town)

WELL PURPOSE: Home
(home, irrigation, municipal, industrial)

CODED

- WELL COMPLETION DATA:
- (1) diameter (inches) 2
 - (2) total depth (feet) 863
 - (3) static water level (feet) Flow ^{below} above top of ground.
 - (4) casing Galv. 843
(material) (depth)
2 If telescope see back.
(size)
 - (5) screen 20' 843
(length) (depth to top)
2, S. Steel
(size) (material)
 - (6) pump ✓ 15
(HP) (yield gpm)
✓
(type power)
 - (7) electric log No
(yes or no)
(organization running log)
 - (8) how well bottom plugged B.W. Valve

DRILLERS REMARKS:


DEPT. OF NATURAL RESOURCES
BUREAU OF LAND & WATER RESOURCES

AUG 15 1980

RECEIVED

If well telescopes please sketch and show depths.

GROUND LEVEL

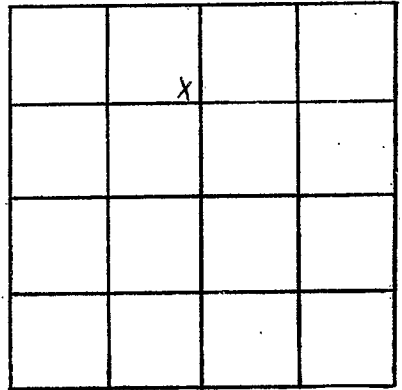

SECTION 2

Please indicate well location X.

ADDITIONAL INFORMATION

If more than one screen,
show locations of each on sketch.