

MISSISSIPPI DEPARTMENT OF NATURAL RESOURCES  
Bureau of Land and Water Resources

Southport Mall

P.O. Box 10631

Jackson, Mississippi 39209

WATER WELL DRILLERS LOG

**CODED**

Pearl River  
W177  
4-14-81

4/14 1981 Bud Penton Pearl River  
date well completed firm name county well located

LANDOWNER: Kenneth Thompson PO  
Box N7 Pilgrimage Miss  
(mailing address)

WELL LOCATION:  
sec. 33 T 7 N R. 17 E  
2 1/2' miles West of Madison  
(distance) (direction) (nearest town)

WELL PURPOSE: Home  
(home, irrigation, municipal, industrial)

WELL COMPLETION DATA:

(1) diameter (inches) 2"

(2) total depth (feet) 1108

(3) static water level (feet) 1266 below above top of ground.

(4) casing 900, 1108, 1088  
(material) (depth)

(size) if telescope see back.

(5) screen 2x80, 1098  
(length) (depth to top)

12, SS Steel  
(size) (material)

(6) pump 70  
(HP) (yield gpm)

(type power)


(7) electric log no  
(yes or no)

(organization running log)

(8) how well bottom plugged slight

description of formations encountered	from	to
<u>white shale</u>	<u>0</u>	<u>40</u>
<u>white sand</u>	<u>40</u>	<u>60</u>
<u>blue shale</u>	<u>60</u>	<u>480</u>
<u>gray sand</u>	<u>480</u>	<u>610</u>
<u>blue shale</u>	<u>610</u>	<u>760</u>
<u>gray sand</u>	<u>760</u>	<u>810</u>
<u>blue shale</u>	<u>810</u>	<u>1050</u>
<u>gray sand</u>	<u>1050</u>	<u>1108</u>


**CODED**

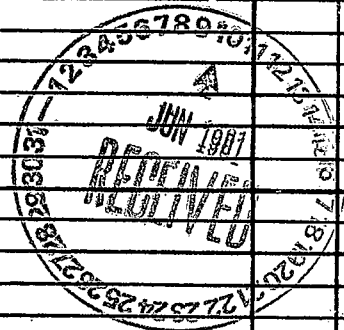

DRILLERS REMARKS:

If well telescopes please sketch and show depths.

GROUND LEVEL

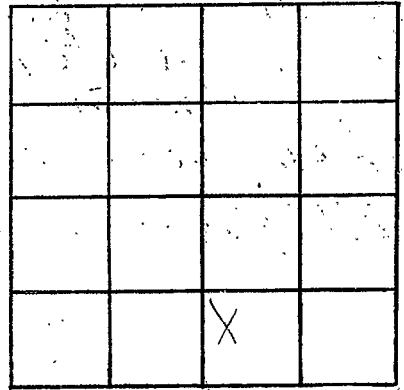

SECTION \_\_\_\_\_

Please indicate well location X.

**ADDITIONAL INFORMATION**

A series of horizontal lines for writing additional information.

If more than one screen, show locations of each on sketch.