

MISSISSIPPI DEPARTMENT OF NATURAL RESOURCES

Bureau of Land and Water Resources

Southport Mall

P.O. Box 10631

Jackson, Mississippi 39209

WATER WELL DRILLERS LOG

CODED ✓

Pearl River  
W 182  
12/14/84

12-14 1984 PENTON WELL SERV. PEARL RIVER  
date well completed firm name county well located

LANDOWNER: Wayne Furr  
Sec. Line Rd.  
Picayune, Ms.  
(mailing address)

description of formations encountered	from	to
SURFACE CLAY	0	40
SAND & GRAVEL	40	90
BLUE CLAY	90	370
SLAND	370	464

WELL LOCATION:  
sec. 27 T. 6 S. R. 17 W.  
1/2 miles South of Picayune  
(distance) (direction) (nearest town)

WELL PURPOSE: HOME  
(home, irrigation, municipal, industrial)

- WELL COMPLETION DATA:
- (1) diameter (inches) 2
  - (2) total depth (feet) 464'
  - (3) static water level (feet) 20' below above top of ground.
  - (4) casing PVC, 454'  
(material) (depth)
  - 2 if telescope see back.  
(size)
  - (5) screen 10', 454'  
(length) (depth to top)
  - 2, PVC  
(size) (material)
  - (6) pump 1 (HP) (yield gpm)  
Elec  
(type power)
  - (7) electric log NO  
(yes or no)
  - (organization running log)
  - (8) how well bottom plugged B.W.

CODED


RECEIVED  
JAN 24 1985

Department of Natural Resources  
Bureau of Land and Water Resources

DRILLERS REMARKS:

If well telescopes please  
sketch and show depths.

GROUND LEVEL

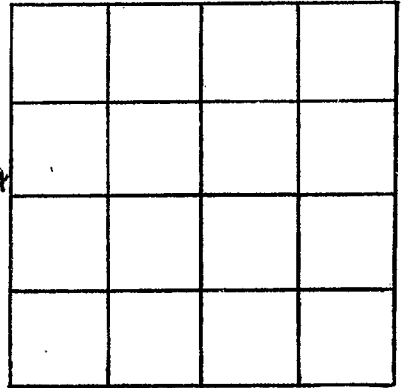

SECTION 27

Please indicate well location X.

ADDITIONAL INFORMATION

If more than one screen,  
show locations of each on sketch.