

MISSISSIPPI DEPARTMENT OF NATURAL RESOURCES

Bureau of Land and Water Resources

Southport Mall

P.O. Box 10631

Jackson, Mississippi 39209

WATER WELL DRILLERS LOG

CODED

PEARL RIVER
W184

4-21 1986 PENTON WELL SERV PEARL RIVER
date well completed firm name county well located

LANDOWNER: BARRY PEARSON
PECAN GROVE TRAILER PARK
NICHOLSON, MS. 39463
(mailing address)

description of formations encountered	from	to
CLAY	0	15
SAND & GRAVEL	15	80
CLAY	80	260
SAND	260	440
CLAY	440	730
SAND	730	865


WELL LOCATION:
sec. 2 T. 6 S. R. 18 E.
3 miles WEST of PICAYUNE
(distance) (direction) (nearest town)

WELL PURPOSE: HOME
(home, irrigation, municipal, industrial)

WELL COMPLETION DATA:

- (1) diameter (inches) 2"
- (2) total depth (feet) 865'
- (3) static water level (feet) Flow below top of ground.
- (4) casing PVC, 845',
(material) (depth)
2" if telescope see back.
(size)
- (5) screen 20', 845',
" (length) (depth to top)
2" PVC
(size) (material)
- (6) pump (HP) (yield gpm)
(type power)
- (7) electric log No
(yes or no)
(organization running log)
- (8) how well bottom plugged B.W.

CODED

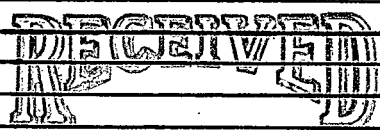


MAY 20 1986

Department of Natural Resources
Bureau of Land & Water Resources

DRILLERS REMARKS:

If well telescopes please sketch and show depths.

GROUND LEVEL

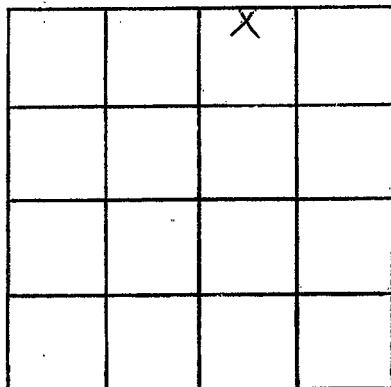

SECTION _____

Please indicate well location X.

ADDITIONAL INFORMATION

If more than one screen,
show locations of each on sketch.