

Pearl River
W185
8-30-68

MISSISSIPPI
 BOARD OF WATER COMMISSIONERS
 416 North State Street
 Jackson, Mississippi 39201

CODED

WATER WELL DRILLERS LOG

8-30 1968 Porton Well Serv Pearl River
 date well completed firm name county well located

LANDOWNER: Made Arceneau
Rt 4 Box 323
Picayune MISS.
 (mailing address)

WELL LOCATION:
sec 17 T 6 S R 17 W
1 miles West of Picayune
 (distance) (direction) (nearest town)


WELL PURPOSE: Home
 (home, irrigation, municipal, industrial)

WELL COMPLETION DATA: 4 1/2 Drilled

- (1) diameter (inches) 2"
- (2) total depth (feet) 841
- (3) static water level (feet) Flow above top of ground.
- (4) casing Black, 82'
 (material) (depth)
2" if telescope see back.
 (size)
- (5) screen 20', 82'
 (length) (depth to top)
2", S. Steel
 (size) (material)
- (6) pump L, 60
 (HP) (yield gpm)
L
 (type power)
- (7) electric log NO
 (yes or no)
 (organization running log)
- (8) how well bottom plugged BW Valve

description of formations encountered	From	To
Clay	0	18
Sand + Gravel	18	75
Blue Clay	75	110
Sandy clay	110	165
Blue Clay	165	297
Sandy Clay	297	325
Grey Sand	325	395
Hard Clay	395	400
SAND	400	437
Blue Clay	437	610
Mud	610	630
SAND	630	676
Blue Clay	676	755
Grey sand	755	772
Blue Clay	772	780
Grey Sand	780	841

CODED

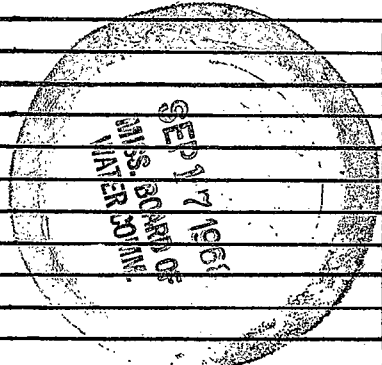

DRILLERS REMARKS:

If well telescopes please sketch and show depths.

GROUND LEVEL

x			

SECTION 17

Please indicate well location X.

ADDITIONAL INFORMATION

If more than one screen,
show locations of each on sketch.