

Live's in L2. Address unknown

Pearl River
W 186
9-6-68

MISSISSIPPI
BOARD OF WATER COMMISSIONERS
416 North State Street
Jackson, Mississippi 39201

CODED

WATER WELL DRILLERS LOG

9-6 1968 Ponton Well Serv Pearl River
date well completed firm name county well located

LANDOWNER: Frank Roberson

deceased

description of formations encountered

From

To

Red Clay	0	35
Sand + Gravel	35	75
Blue Clay	75	268
Corey Sand	268	342
Blue Clay	342	505
Corey Sand	505	512
Blue Clay	512	538
Corey Sand	538	620
Blue Clay	620	760
Corey Sand	760	838

(mailing address)

WELL LOCATION:

sec. 3 T 6 R 17
0 miles N.W. of Peayune
(distance) (direction) (nearest town)


WELL PURPOSE: Pond
(home, irrigation, municipal, industrial)

WELL COMPLETION DATA: 4 1/2 Drilled

- (1) diameter (inches) 2"
- (2) total depth (feet) 838
- (3) static water level (feet) Flow above top of ground.
- (4) casing Black 818
(material) (depth)
- 3" If telescope see back.
(size)
- (5) screen 20' 818
(length) (depth to top)
- 2" S. Steel
(size) (material)
- (6) pump 35
(HP) (yield gpm)
- NO
(type power)
- (7) electric log NO
(yes or no)
- (organization running log)
- (8) how well bottom plugged BW Valve

CODED

Pump

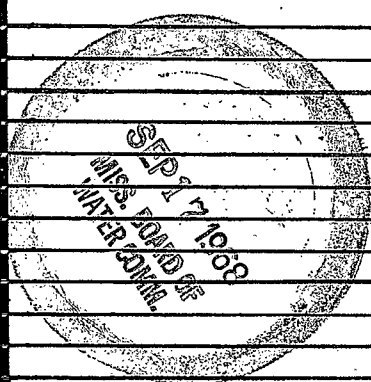

DRILLERS REMARKS:

If well telescopes please sketch and show depths.

GROUND LEVEL

			X

SECTION 3

Please indicate well location X.

ADDITIONAL INFORMATION

If more than one screen, show locations of each on sketch.