

PEARL RIVER
W 187
3-18-76

MISSISSIPPI
BOARD OF WATER COMMISSIONERS
416 North State Street
Jackson, Mississippi 39201

CODED

WATER WELL DRILLERS LOG

3-18-1976 date well completed
130
176 Leuphin Well Co. firm name
Pearl River county well located

LANDOWNER:	description of formations encountered	from	to
Glen Rossett			
Pecaiune, Miss - (mailing address)	Sand	15	60
	Clay	60	125
WELL LOCATION: ✓ sec. 6 T. 16 N. R. 18 E 4 miles N.W. of Pecaiune (distance) (direction) (nearest town)	Sand	125	210
	Good Sand	210	420
	Clay	420	565
	Sand	565	610
	Clay	610	715
	Sand	715	865
	Clay	865	940
	Sand	940	997
WELL PURPOSE: (home, irrigation, municipal, industrial)	Home		

WELL COMPLETION DATA:

(1) diameter (inches) 2"

(2) total depth (feet) 997'

(3) static water level (feet) 8" below top of ground. (above)

(4) casing Galv. (material) 976' (depth)

2" (size) if telescope see back.

(5) screen 20' (length) 976' (depth to top)

2" (size) S.S. (material)

(6) pump NO (HP) 50 (yield gpm)

NO (type power)

(7) electric log NO (yes or no)

NO (organization running log)

(8) how well bottom plugged Good
Shark


CODED

DRILLERS REMARKS:

MAR 25 1976

If well telescopes please sketch and show depths.

GROUND LEVEL

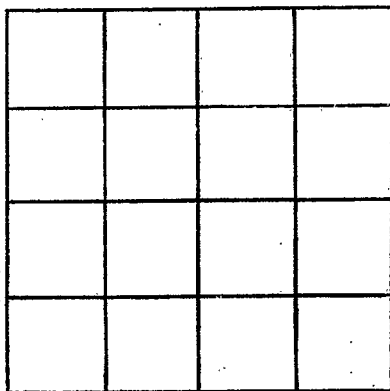

SECTION _____

Please indicate well location X.

ADDITIONAL INFORMATION

If more than one screen, show locations of each on sketch.