

Pearl River
 W188
 6-24-76

MISSISSIPPI
 BOARD OF WATER COMMISSIONERS
 416 North State Street
 Jackson, Mississippi 39201

CODED

WATER WELL DRILLERS LOG

6-24-1976 date well completed
 26 Lumbkin Well Ser. firm name
 Pearl River county well located

LANDOWNER:
 Mr. Kent Robinson
 Picayune Miss
 (mailing address)

description of formations encountered	from	to
Clay	0	18
Sand	18	80
Clay	80	145
Sand	145	230
Clay	230	250
Sand	250	315
Clay	315	370
Sand	370	500
Clay	500	650
Sand	650	730
Clay	730	910
fine sand	910	930
hard sand	930	1037

WELL LOCATION:
 sec. 1 T 6 N R 18 E
 7 miles West of Picayune
 (distance) (direction) (nearest town)

WELL PURPOSE: Home
 (home, irrigation, municipal, industrial)

- WELL COMPLETION DATA:
- (1) diameter (inches) 2"
 - (2) total depth (feet) 1037
 - (3) static water level (feet) 5" below top of ground.
 - (4) casing Gal. 1.016' (material) (depth)
 2" (size) if telescope see back.
 - (5) screen 20' 1.016' (length) (depth to top)
 2" (size) Galvanized Steel (material)
 - (6) pump No 29C.P.M. (HP) (yield gpm)
 N. (type power)
 - (7) electric log No (yes or no)

(organization running log)
 (8) how well bottom plugged James Shaw

DRILLERS REMARKS:


CODED

RECEIVED
 OCT 26 1976

MISS. BD. OF WATER COMMISSIONERS

If well telescopes please sketch and show depths.

GROUND LEVEL

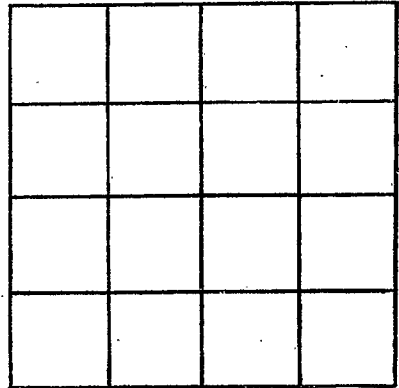

SECTION _____

Please indicate well location X.

ADDITIONAL INFORMATION

If more than one screen, show locations of each on sketch.