

Pearl River  
W 189  
6-30-76

MISSISSIPPI  
 BOARD OF WATER COMMISSIONERS  
 416 North State Street  
 Jackson, Mississippi 39201

CODED

WATER WELL DRILLERS LOG

6-30 1976 Pardon Well Serv Pearl River  
 date well completed firm name county well located

LANDOWNER: J.M. Stockstill  
Pr. 4  
Picayune MS  
 (mailing address)

WELL LOCATION:  
 sec. 32 T. 6 N. R. 17 E.  
 S  W  
1 miles SW of Picayune  
 (distance) (direction) (nearest town)

WELL PURPOSE: Home  
 (home, irrigation, municipal, industrial)

WELL COMPLETION DATA:

(1) diameter (inches) 2

(2) total depth (feet) 970

(3) static water level (feet) Flow <sup>below</sup> above top of ground.

(4) casing Corlu 950  
 (material) (depth)  
2 if telescope see back.  
 (size)

(5) screen 20' 950  
 (length) (depth to top)  
2 St. Steel  
 (size) (material)

(6) pump 50  
 (HP) (yield gpm)  
 (type power)

(7) electric log NO  
 (yes or no)  
 (organization running log)

(8) how well bottom plugged B.W. valve

description of formations encountered	from	to
Surface Clay	0	30
Sand	20	38
Clay	38	45
Sand	45	68
Blue clay	68	300
Sand	200	300
Blue Clay	300	430
Sand	430	530
Blue Clay	530	570
Sand	570	610
Blue clay	610	670
Sand	670	800
Blue Clay	680	800
Sand	800	850
Blue Clay	850	920
Sand	920	970

CODED


DRILLERS REMARKS: 20 lbs

RECEIVED  
 JUL - 6 1976

MISS. BO. OF WATER COMMISSIONERS

If well telescopes please sketch and show depths.

GROUND LEVEL

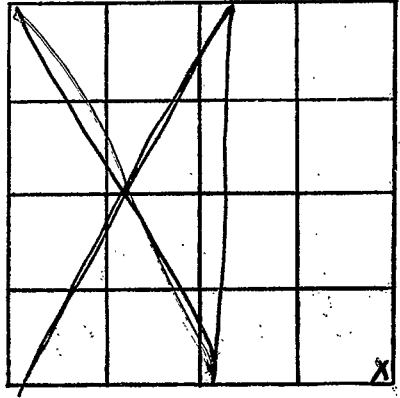

SECTION 32

Please indicate well location X.

ADDITIONAL INFORMATION

If more than one screen, show locations of each on sketch.