

Pearl River
W 190
8-19-76

MISSISSIPPI
 BOARD OF WATER COMMISSIONERS
 416 North State Street
 Jackson, Mississippi 39201

CODED

WATER WELL DRILLERS LOG

8-19 1976 26 Lemphig Well Sec. Pearl River
 date well completed firm name county well located

LANDOWNER:
Mr. C. S. Seal
Picoune, Miss.
 (mailing address)

WELL LOCATION:
 sec. 3 T. 6 N. R. 18 E. W. 1
Five miles West of Pearson
 (distance) (direction) (nearest town)

WELL PURPOSE: Home
 (home, irrigation, municipal, industrial)

- WELL COMPLETION DATA:
- (1) diameter (inches) 2"
 - (2) total depth (feet) 877'
 - (3) static water level (feet) 5' below top of ground.
 - (4) casing Gal. 850'
 (material) (depth)
2"
 (size) if telescope see back.
 - (5) screen 21' 850'
 (length) (depth to top)
2" Stainless Steel
 (size) (material)
 - (6) pump No. 40'
 (HP) (yield gpm)
None.
 (type power)
 - (7) electric log No.
 (yes or no)

(organization running log)
 (8) how well bottom plugged Sand about

description of formations encountered	from	to
Clay	0	12
soil	12	28
Clay	28	40
soil	40	95
Clay	95	140
soil	140	230
Clay	230	360
soil	360	470
Clay	470	630
soil	630	760
Clay	760	790
soil	790	877

CODED


RECEIVED
 OCT 26 1976

MISS. BD. OF WATER COMMISSIONERS

DRILLERS REMARKS:

If well telescopes please sketch and show depths.

GROUND LEVEL

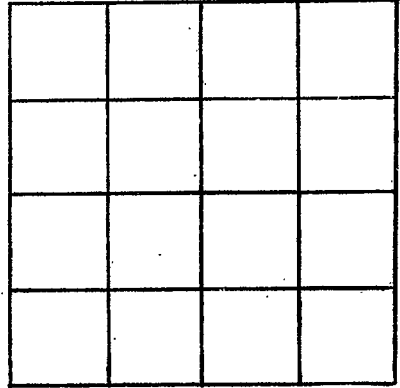

SECTION _____

Please indicate well location X.

ADDITIONAL INFORMATION

If more than one screen, show locations of each on sketch.