

Pearl River
W 191
9-22-76

MISSISSIPPI
 BOARD OF WATER COMMISSIONERS
 416 North State Street
 Jackson, Mississippi 39201

CODED

WATER WELL DRILLERS LOG

9-29 ^{13V} 26 Memphis Well Ser. Pearl River
 date well completed firm name county well located

LANDOWNER:
Mr. Clyde Stewart
Picayune, Miss
 (mailing address)

WELL LOCATION:
 sec. 17 T. 2 N. R. 10 E.
Three miles West of Picayune
 (distance) (direction) (nearest town)

WELL PURPOSE: drone
 (home, irrigation, municipal, industrial)

- WELL COMPLETION DATA:
- (1) diameter (inches) 2"
 - (2) total depth (feet) 1543
 - (3) static water level (feet) 411 below above top of ground.
 - (4) casing Gal. 1522
 (material) (depth)
2"
 (size) If telescope see back.
 - (5) screen 21' 1522
 (length) (depth to top)
3" Stainless Steel
 (size) (material)
 - (6) pump No 36 G.P.M.
 (HP) (yield gpm)
None
 (type power)
 - (7) electric log No
 (yes or no)

(organization running log)
 (8) how well bottom plugged hard shell

description of formations encountered	from	to
Clay	0	45
Sand	45	100
Clay	100	340
Sand	340	525
Clay	525	625
Sand	625	775
Clay	775	880
Sand	880	985
Clay	985	1055
Sand	1055	1270
Clay	1270	1490
Sand	1490	1543

CODED


RECEIVED
 OCT 26 1976

MISS. BD. OF WATER COMMISSIONERS

DRILLERS REMARKS:

If well telescopes please sketch and show depths.

GROUND LEVEL

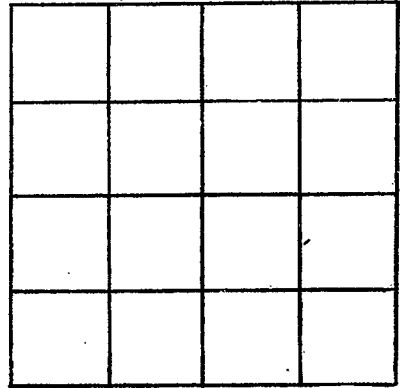

SECTION _____

Please indicate well location X.

ADDITIONAL INFORMATION

If more than one screen, show locations of each on sketch.