

Pearl River
W 192
10-1-76

MISSISSIPPI
BOARD OF WATER COMMISSIONERS
416 North State Street
13V Jackson, Mississippi 39201

CODED

WATER WELL DRILLERS LOG

10-1 1976 Penton Well Serv Pearl River
date well completed firm name county well located

LANDOWNER: Reese Moody
Rt.
Picayune MS-
(mailing address)

WELL LOCATION:
Sec 28 T 6 R 17
31 37
1/4 miles SW of Picayune
(distance) (direction) (nearest town)

WELL PURPOSE: Home
(home, irrigation, municipal, industrial)

WELL COMPLETION DATA:

- (1) diameter (inches) 2
- (2) total depth (feet) 1009
- (3) static water level (feet) Flow below top of ground.
- (4) casing Galv. 989
(material) (depth)
2 if telescope see back.
(size)
- (5) screen 20' 989
(length) (depth to top)
2 S. Steel
(size) (material)
- (6) pump 35
(HP) (yield gpm)
(type power)
- (7) electric log NO
(yes or no)
(organization running log)
- (8) how well bottom plugged B.W. Valve

description of formations encountered	from	to
Surface Clay	0	35
Blue Clay	35	257
Sand	257	275
Blue Clay	275	460
Sand	460	510
Blue Clay	510	690
Sand	690	705
Blue Clay	705	900
Sand	900	1009

CODED


RECEIVED
NOV 11 1976

MISS. Bd. OF WATER COMM.

DRILLERS REMARKS: 8 lbs Pressure

If well telescopes please sketch and show depths.

GROUND LEVEL

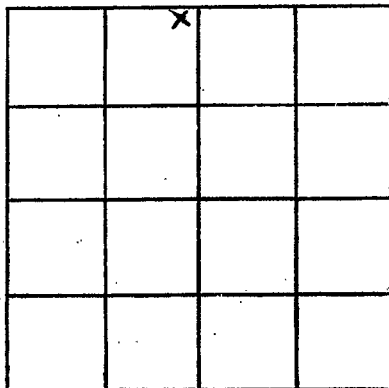

SECTION 28

Please indicate well location X.

ADDITIONAL INFORMATION

If more than one screen,
show locations of each on sketch.