

Pearl River
W 193
6-25-77

MISSISSIPPI
 BOARD OF WATER COMMISSIONERS
 416 North State Street
 13V Jackson, Mississippi 39201

CODED

WATER WELL DRILLERS LOG

6-25 1977 Penton Well Serv. Pearl River
 date well completed firm name county well located

LANDOWNER: Ralph Ford
Nicholson Miss.
 (mailing address)
 WELL LOCATION:
 sec. 36 T. 7 R. 17
 (distance) (direction) (nearest town)
1 miles East of Nicholson

description of formations encountered	from	to
Surface Clay	0	30
Sand & Gravel	30	110
Blue Clay	110	160
Silt	160	190
Blue Clay	190	440
Sand	440	505
Blue Clay	505	610
Sand	610	630
Blue Clay	630	880
Sand	880	930

WELL PURPOSE: Home
 (home, irrigation, municipal, industrial)

WELL COMPLETION DATA:

(1) diameter (inches) 2

(2) total depth (feet) 930'

(3) static water level (feet) Flow below top of ground.

(4) casing Galv. 910
 (material) (depth)
2 if telescope see back.
 (size)

(5) screen 20 910
 (length) (depth to top)
2 S. Steel
 (size) (material)

(6) pump _____ (HP) _____ (yield gpm)
 (type power)

(7) electric log NO
 (yes or no)

(organization running log)

(8) how well bottom plugged Bw Valve

CODED

NEW OWNER?

RECEIVED


AUG 4 1977

DRILLERS REMARKS:

MISS. BD. OF WATER COMM.

If well telescopes please sketch and show depths.

GROUND LEVEL

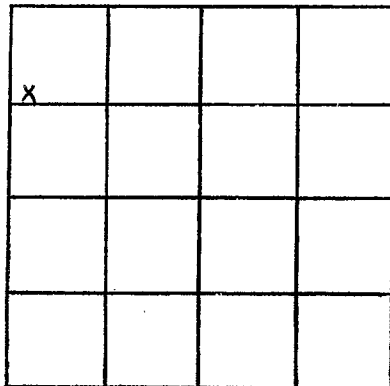

SECTION 35

Please indicate well location X.

ADDITIONAL INFORMATION

If more than one screen, show locations of each on sketch.