

Pearl River  
W 194  
8-2-77

MISSISSIPPI  
 BOARD OF WATER COMMISSIONERS  
 416 North State Street  
 Jackson, Mississippi 39201

CODED

WATER WELL DRILLERS LOG

8-2  
 date well completed

13V

1972 STOCKSTILL BROS., INC.

firm name

Pearl River  
 county well located

LANDOWNER:  
Mr. Clifton Furr  
Pearl River, Miss.  
 (mailing address)

description of formations encountered	from	to
Clay	0	15
Sand	15	90
Clay	90	315
Sand	315	460
Clay	460	640
Sand	640	700
Clay	700	790
Sand	790	908
Clay	908	1015
Sand	1015	1065
Clay	1065	1085
Sand	1085	1185

WELL LOCATION:  
 sec. 12 T. 6 N. R. 18 E.  
9 miles W of Pearl River  
 (distance) (direction) (nearest town)

WELL PURPOSE: Home  
 (home, irrigation, municipal, industrial)

- WELL COMPLETION DATA:
- diameter (inches) 2"
  - total depth (feet) 1185
  - static water level (feet) 6" below above top of ground.
  - casing Gal. 1165'  
 (material) (depth)  
2" if telescope see back.  
 (size)
  - screen 20 1165'  
 (length) (depth to top)  
2" Stainless steel  
 (size) (material)
  - pump No 40  
 (HP) (yield gpm)  
No  
 (type power)
  - electric log No  
 (yes or no)  
No  
 (organization running log)
  - how well bottom plugged Sand & silt

CODED


RECEIVED  
 SEP 22 1972

MISS. BD. OF WATER COMMISSIONERS

DRILLERS REMARKS:

If well telescopes please  
sketch and show depths.

GROUND LEVEL

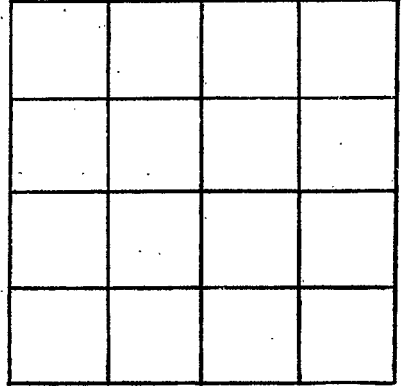

SECTION \_\_\_\_\_

Please indicate well location X.

ADDITIONAL INFORMATION

A series of horizontal lines providing space for additional information.

If more than one screen,  
show locations of each on sketch.