

PEARL RIVER

W 196

8-29-78

MISSISSIPPI
BOARD OF WATER COMMISSIONERS
416 North State Street
Jackson, Mississippi 39201

CODING

WATER WELL DRILLERS LOG

8-29-78

date well completed

Penton Well Serv

firm name

Pearl River

county well located

LANDOWNER: Jerry Thigden

Nicholson - MS

On 607 Serial Tank Sew.
(mailing address)

WELL LOCATION:

sec. 3 T 7 R 17
0 miles South of Nicholson
(distance) (direction) (nearest town)

description of formations encountered

from to

Clay	0	20
Sand + Gravel	20	110
Blue Clay	110	240
Sand	240	320
Blue Clay	320	410
Sand	410	540
Blue Clay	540	900
Sand	900	998

WELL PURPOSE: home
(home, irrigation, municipal, industrial)

CODING

WELL COMPLETION DATA:

- (1) diameter (inches) 2"
- (2) total depth (feet) 998'
- (3) static water level (feet) Flow below top of ground.
- (4) casing Galv 2" (size) 978' (depth) if telescope see back.
- (5) screen 20' (length) 978' (depth to top) 2" (size) S. Steel (material)
- (6) pump (HP) (yield gpm) (type power)
- (7) electric log NO (yes or no) (organization running log)
- (8) how well bottom plugged B.W. Valve


RECEIVED
SEP 21 1978

DRILLERS REMARKS:

MISS. BD. OF WATER COMMISSIONERS

If well telescopes please sketch and show depths.

GROUND LEVEL

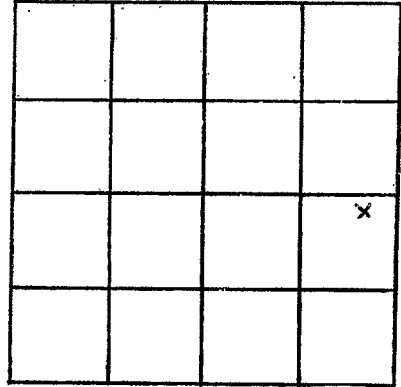

SECTION 3

Please indicate well location X.

ADDITIONAL INFORMATION

Lined area for additional information.

If more than one screen, show locations of each on sketch.