

PEARL RIVER
 W 197
 8-12-78

MISSISSIPPI
 BOARD OF WATER COMMISSIONERS
 416 North State Street
 Jackson, Mississippi 39201

CODED

WATER WELL DRILLERS LOG

8-12-78 19 Penton Well Serv Pearl River
 date well completed firm name county well located

LANDOWNER: Billy Shoemaker
Nicholson, MS.
 (mailing address)
 WELL LOCATION:
 sec. 3 T 7 R 17
0 miles South of Nicholson
 (distance) (direction) (nearest town)

description of formations encountered	from	to
Clay	0	10
Sand	10	60
Blue Clay	60	220
Sand	220	260
Blue Clay	260	400
Sand	400	540
Blue Clay	540	880
Sand	880	987

WELL PURPOSE: home
 (home, irrigation, municipal, industrial)

WELL COMPLETION DATA:
 (1) diameter (inches) 2"
 (2) total depth (feet) 987'
 (3) static water level (feet) Flow below above top of ground.
 (4) casing Galv 967'
 (material) (depth)
2" if telescope see back.
 (size)
 (5) screen 20' 967'
 (length) (depth to top)
2" S. Steel
 (size) (material)
 (6) pump _____
 (HP) (yield gpm)
 (type power)
 (7) electric log No
 (yes or no)
 (organization running log)
 (8) how well bottom plugged B.W. Value

CODED


RECEIVED

SEP 21 1978

DRILLERS REMARKS:

If well telescopes please sketch and show depths.

GROUND LEVEL

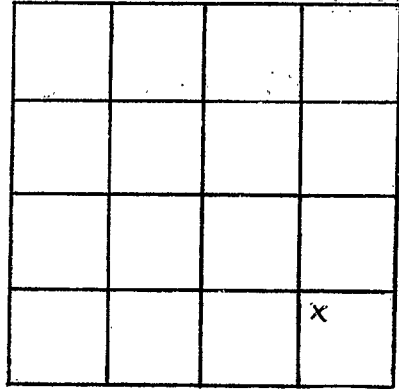

SECTION 3

Please indicate well location X.

ADDITIONAL INFORMATION

If more than one screen, show locations of each on sketch.