

CODED

PEARL RIVER
W 198
8-19-78

MISSISSIPPI
BOARD OF WATER COMMISSIONERS
416 North State Street
Jackson, Mississippi 39201

WATER WELL DRILLERS LOG

8-19-78 date well completed 19 Penton Well Serv firm name Pearl River county well located

LANDOWNER: Arnold Spense
Rn
Picayune, MS
(mailing address)

WELL LOCATION:
sec. 17 T. 6 S. R. 17 E. W.
1/2 miles S.W. of Picayune
(distance) (direction) (nearest town)

WELL PURPOSE: home
(home, irrigation, municipal, industrial)

WELL COMPLETION DATA:

(1) diameter (inches) 2"

(2) total depth (feet) 1169'

(3) static water level (feet) Flow below above top of ground.

(4) casing Galv, 1149'
(material) (depth)

2"
(size) if telescope see back.

(5) screen 20', 1149'
(length) (depth to top)

2", S. Steel
(size) (material)

(6) pump
(HP) (yield gpm)

(type power)

(7) electric log No
(yes or no)

(organization running log)

(8) how well bottom plugged B.W. Value

description of formations encountered	from	to
Clay	0	20
Sand+Gravel	20	100
Blue Clay	100	300
Sand	300	460
Blue Clay	460	660
Sand	660	700
Blue Clay	700	780
Sand	780	915
Blue Clay	915	1060
Sand	1060	1169

CODED

Pump


RECEIVED

SEP 21 1978

DRILLERS REMARKS:

If well telescopes please sketch and show depths.

GROUND LEVEL

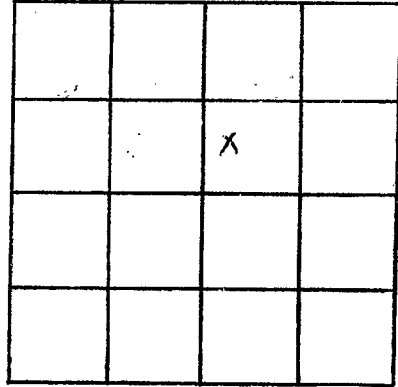

SECTION 17

Please indicate well location X.

ADDITIONAL INFORMATION

Lined area for additional information.

If more than one screen, show locations of each on sketch.