

PEARL RIVER

W 199

04-02-79

MISSISSIPPI BOARD OF WATER COMMISSIONERS
416 North State Street
Jackson, Mississippi 39201

CODED

WATER WELL DRILLERS LOG

4-2 1979 Penton well Serv Pearl River
date well completed firm name county well located

LANDOWNER: J. B. Riles

Rt. 4

Picayune, Ms.
(mailing address)

WELL LOCATION:

sec. 17 T 4 S R 17 W
1 miles West of Picayune
(distance) (direction) (nearest town)

WELL PURPOSE: Home
(home, irrigation, municipal, industrial)

WELL COMPLETION DATA:

- (1) diameter (inches) 2
- (2) total depth (feet) 1230
- (3) static water level (feet) Flow below above top of ground.
- (4) casing Galv. 1210
(material) (depth)
2" if telescope see back.
(size)
- (5) screen 20' 1210
(length) (depth to top)
2" S. Steel
(size) (material)
- (6) pump 25
(HP) (yield gpm)
(type power)
- (7) electric log NO
(yes or no)

(organization running log)

(8) how well bottom plugged BW Valve

description of formations encountered

from to

Surface Clay	0	20
Sand + Gravel	20	110
Blue Clay	110	340
Sand	340	530
Blue Clay	530	700
Sand	700	750
Blue Clay	750	880
Sand	880	960
Blue Clay	960	1100
Sand	1100	1230

CODED

PUMP

Miss. Board of Water Comm.


MAY - 7 1979

DRILLERS REMARKS:

RECEIVED

If well telescopes please sketch and show depths.

GROUND LEVEL

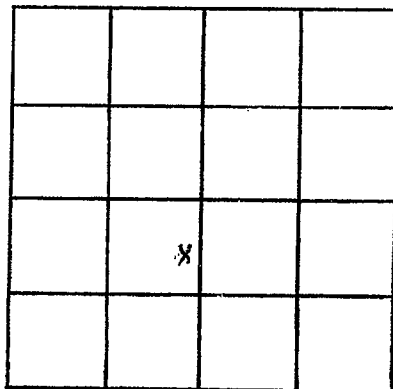

SECTION 17

Please indicate well location X.

ADDITIONAL INFORMATION

If more than one screen,
show locations of each on sketch.