

Pearl River  
W 201

MISSISSIPPI  
BOARD OF WATER COMMISSIONERS  
416 North State Street  
Jackson, Mississippi 39201

CODED


WATER WELL DRILLERS LOG

Aug. 1984 1983 date well completed  
H.D. Well Dr. firm name  
Pearl River county well located

LANDOWNER: <u>Mac Kennedy</u>	description of formations encountered	from	to
<u>Pearl River, Miss</u> (mailing address)	<u>top soil</u>	<u>0</u>	<u>2</u>
WELL LOCATION: sec. <u>4</u> T. <u>6</u> N. R. <u>17</u> E. <u>2</u> miles <u>North</u> of <u>Pearl River</u> (distance) (direction) (nearest town)	<u>sandy clay</u>	<u>2</u>	<u>12</u>
WELL PURPOSE: <u>Home</u> (home, irrigation, municipal, industrial)	<u>sand &amp; gravel</u>	<u>12</u>	<u>35</u>
WELL COMPLETION DATA: (1) diameter (inches) <u>2"</u>	<u>chalk</u>	<u>35</u>	<u>145</u>
(2) total depth (feet) <u>645 ft.</u>	<u>sand</u>	<u>145</u>	<u>170</u>
(3) static water level (feet) <u>flow</u> below top of ground.	<u>white chalk</u>	<u>170</u>	<u>250</u>
(4) casing <u>Plastic</u> , <u>615</u> (material) (depth)	<u>sand &amp; gravel</u>	<u>250</u>	<u>290</u>
<u>2"</u> If telescope see back. (size)	<u>chalk</u>	<u>290</u>	<u>420</u>
(5) screen <u>30 ft.</u> , <u>615</u> (length) (depth to top)	<u>fine sand</u>	<u>420</u>	<u>500</u>
<u>2"</u> <u>Plastic</u> (size) (material)	<u>blue chalk</u>	<u>500</u>	<u>580</u>
(6) pump <u>FLOW</u> (HP) (yield gpm)	<u>chalk sand &amp; gravel</u>	<u>580</u>	<u>645</u>
(type power)	CODED		
(7) electric log (yes or no)	DEPT. OF NATURAL RESOURCES BUREAU OF LAND & WATER RESOURCES		
(organization running log)	JAN 23 1984		
(8) how well bottom plugged <u>PWC</u>	RECEIVED		
DRILLERS REMARKS: <u>[Signature]</u>			

If well telescopes please sketch and show depths.

GROUND LEVEL

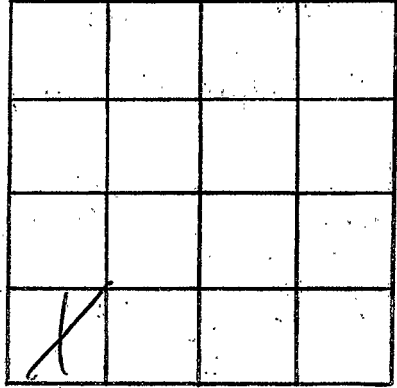

SECTION

4

Please indicate well location X.

ADDITIONAL INFORMATION

If more than one screen,  
show locations of each on sketch.