

CODED

CODED

MISSISSIPPI
BOARD OF WATER COMMISSIONERS
416 North State Street
Jackson, Mississippi 39201

WATER WELL DRILLERS LOG

Pearl River
W-171-202
7-2-81

7-2 1981 Penton Well Serv Pearl River
date well completed firm name county well located

LANDOWNER: Jimmy Loe
P.O. Box 729 R. Log Rd
Picayune MS.
(mailing address)


description of formations encountered	from	to
Surface Clay	0	10
Sand	10	25
Clay	25	50
Sand	50	90
Clay	90	360
Sand	360	445
Clay	445	600
Sand	600	680
Clay	680	800
Sand	800	935
Clay	935	1010
Sand	1010	1100
Clay	1100	1140
Sand	1140	1225

WELL LOCATION:
sec. 25 T 6 R 17 E
112 miles S. of Picayune
(distance) (direction) (nearest town)

WELL PURPOSE: Home
(home, irrigation, municipal, industrial)

WELL COMPLETION DATA:
(1) diameter (inches) 2
(2) total depth (feet) 1225
(3) static water level (feet) Flow below top of ground.
(4) casing Steel 1205'
(material) (depth)
2 If telescope see back.
(size)
(5) screen 20' 1205'
(length) (depth to top)
2 S. Steel
(size) (material)
(6) pump 30
(HP) (yield gpm)
(type power)
(7) electric log NO
(yes or no)
(organization running log)
(8) how well bottom plugged B.W. 1/2 or 1/3

DRILLERS REMARKS:

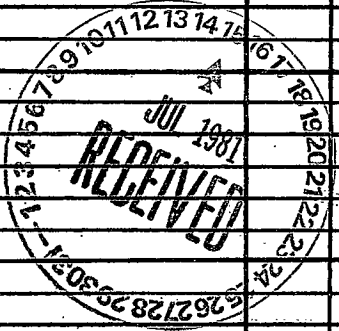

If well telescopes please sketch and show depths.

GROUND LEVEL

X			

SECTION 25

Please indicate well location X.

ADDITIONAL INFORMATION

If more than one screen, show locations of each on sketch.