

MISSISSIPPI DEPARTMENT OF NATURAL RESOURCES

Bureau of Land and Water Resources

Southport Mall

P.O. Box 10631

Jackson, Mississippi 39209

WATER WELL DRILLERS LOG

CODED

PEARL RIVER  
W205

6/10 date well completed 86 BUD PENTON firm name PEARL RIVER county well located  
WATER WELL SERVICE

LANDOWNER: THE CROSBY  
ARBORETUM  
159 SERVICE ROAD  
(mailing address)

description of formations encountered	from	to
WHITE SHALE	0	30
WHITE SAND	30	60
BLUE SHALE	60	320
BLUE SAND	320	370
BLUE SHALE	370	460
GRAY SAND	400	440
BLUE SHALE	440	820
GRAY SAND	820	900
BLUE SHALE	900	1150
GRAY SAND	1150	1220


WELL LOCATION:  
sec. 25 T 36 N R 16 E  
S W  
1 miles E of DICAYUM  
(distance) (direction) (nearest town)

WELL PURPOSE: ARBORETUM  
(home, irrigation, municipal, industrial)

- WELL COMPLETION DATA:
- (1) diameter (inches) 4"
  - (2) total depth (feet) 1220
  - (3) static water level (feet) 6 1/2 <sup>below</sup> above top of ground.
  - (4) casing ~~PEE~~ 1220 (material) 53 steel (depth) (size) if telescope see back.
  - (5) screen 4x20 1200 (length) (depth to top) 12 Stanley steel (size) (material)
  - (6) pump NO (HP) (yield gpm) NO (type power)
  - (7) electric log NO (yes or no) (organization running log)
  - (8) how well bottom plugged sand

DRILLERS REMARKS: Shark


CODED

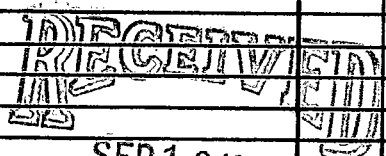

Department of Natural Resources  
Bureau of Land and Water Resources

If well telescopes please sketch and show depths.

GROUND LEVEL

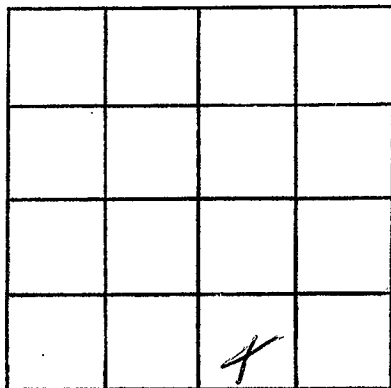

SECTION \_\_\_\_\_

Please indicate well location X.

ADDITIONAL INFORMATION

If more than one screen, show locations of each on sketch.