

MISSISSIPPI DEPARTMENT OF NATURAL RESOURCES

Bureau of Land and Water Resources

Southport Mall

P.O. Box 10631

Jackson, Mississippi 39209

WATER WELL DRILLERS LOG

PEARL RIVER
W 206

1-20 1986 PENTON WELL SERV. PEARL RIVER
date well completed firm name county well located

LANDOWNER: MIKE GARFIELD
RT. 6 Box 4 PICAYUNE
MS.
(mailing-address)

WELL LOCATION:
sec. 3 T. 6 R. 17
1 miles W of PICAYUNE
(distance) (direction) (nearest town)


WELL PURPOSE: HOME
(home, irrigation, municipal, industrial)

WELL COMPLETION DATA:

- (1) diameter (inches) 2"
- (2) total depth (feet) 645'
- (3) static water level (feet) Flow below above top of ground.
- (4) casing PVC 625'
(material) (depth)
2" If telescope see back.
(size)
- (5) screen 20' 625'
(length) (depth to top)
2" PVC
(size) (material)
- (6) pump _____ (HP) _____ (yield gpm)
(type power)
- (7) electric log NO
(yes or no)
(organization running log)
- (8) how well bottom plugged BW

description of formations encountered	from	to
<u>CLAY</u>	<u>0</u>	<u>40</u>
<u>SAND & GRAVEL</u>	<u>40</u>	<u>65</u>
<u>BLUE CLAY</u>	<u>65</u>	<u>250</u>
<u>SAND</u>	<u>250</u>	<u>370</u>
<u>BLUE CLAY</u>	<u>370</u>	<u>560</u>
<u>SAND</u>	<u>560</u>	<u>645</u>


DRILLERS REMARKS:

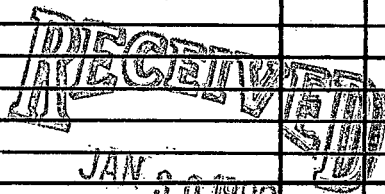

Department of Natural Resources
Bureau of Land & Water Resources

If well telescopes please sketch and show depths.

GROUND LEVEL

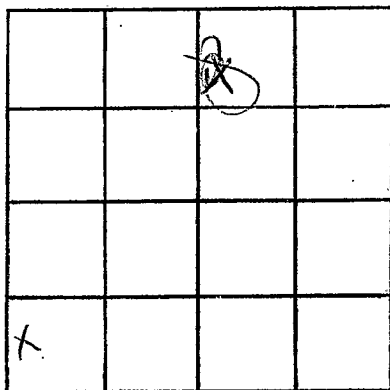

SECTION 3

Please indicate well location X.

ADDITIONAL INFORMATION

If more than one screen,
show locations of each on sketch.